
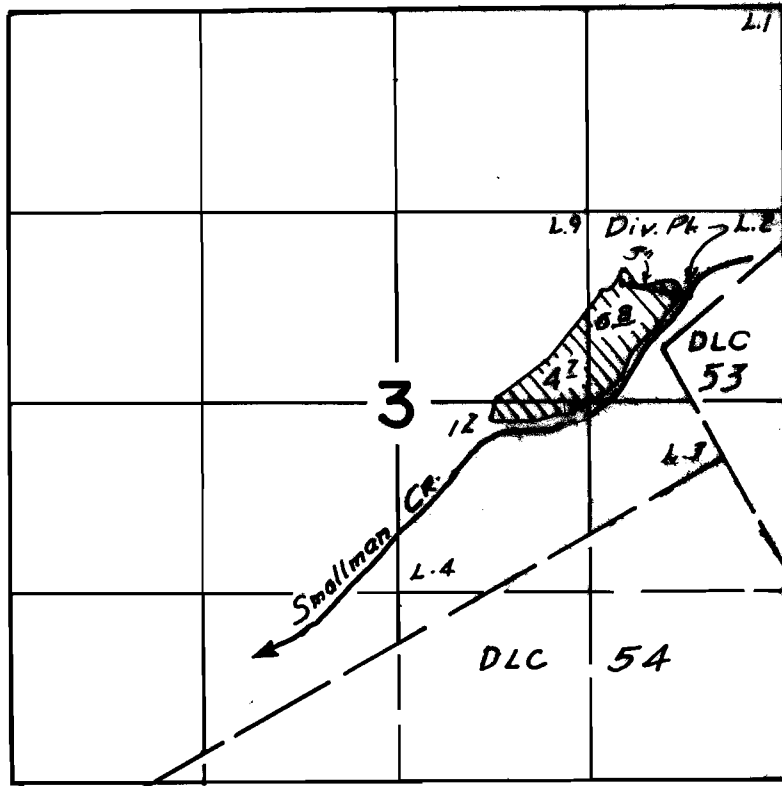


T.10S. R.2W.W.M.

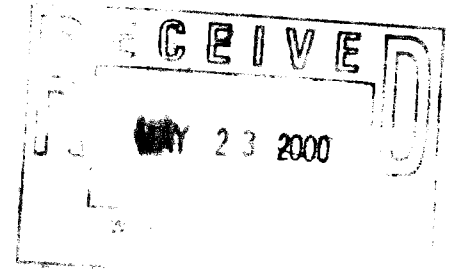

Scale
4" = 1 Mi.


Div. Pt. loc. 430' N & 180' E from W'ly NW Cor DLC 53

FINAL PROOF SURVEY UNDER

Transfer No. T-7375
Application No. Permit No.
IN NAME OF

MT. JEFFERSON FARMS

Surveyed April 24 2000
19..... by

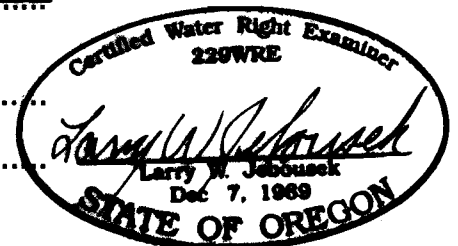

THIS MAP WAS PREPARED FOR THE PURPOSE OF IDENTIFYING THE LOCATION OF A WATER RIGHT ONLY AND IS NOT INTENDED TO PROVIDE LEGAL DIMENSIONS OR LOCATION OF PROPERTY OWNERSHIP LINES.