

25

30

36

31

stock pond #1

stock pond #2

TROUGH #1 & SPRING

stock pond #3

TROUGH #2

TROUGH #4

Catherine

T4S

T5S

T5S

S

S

330

1056

792

1056

1056

1200

726


135

2380

264

1516

2494

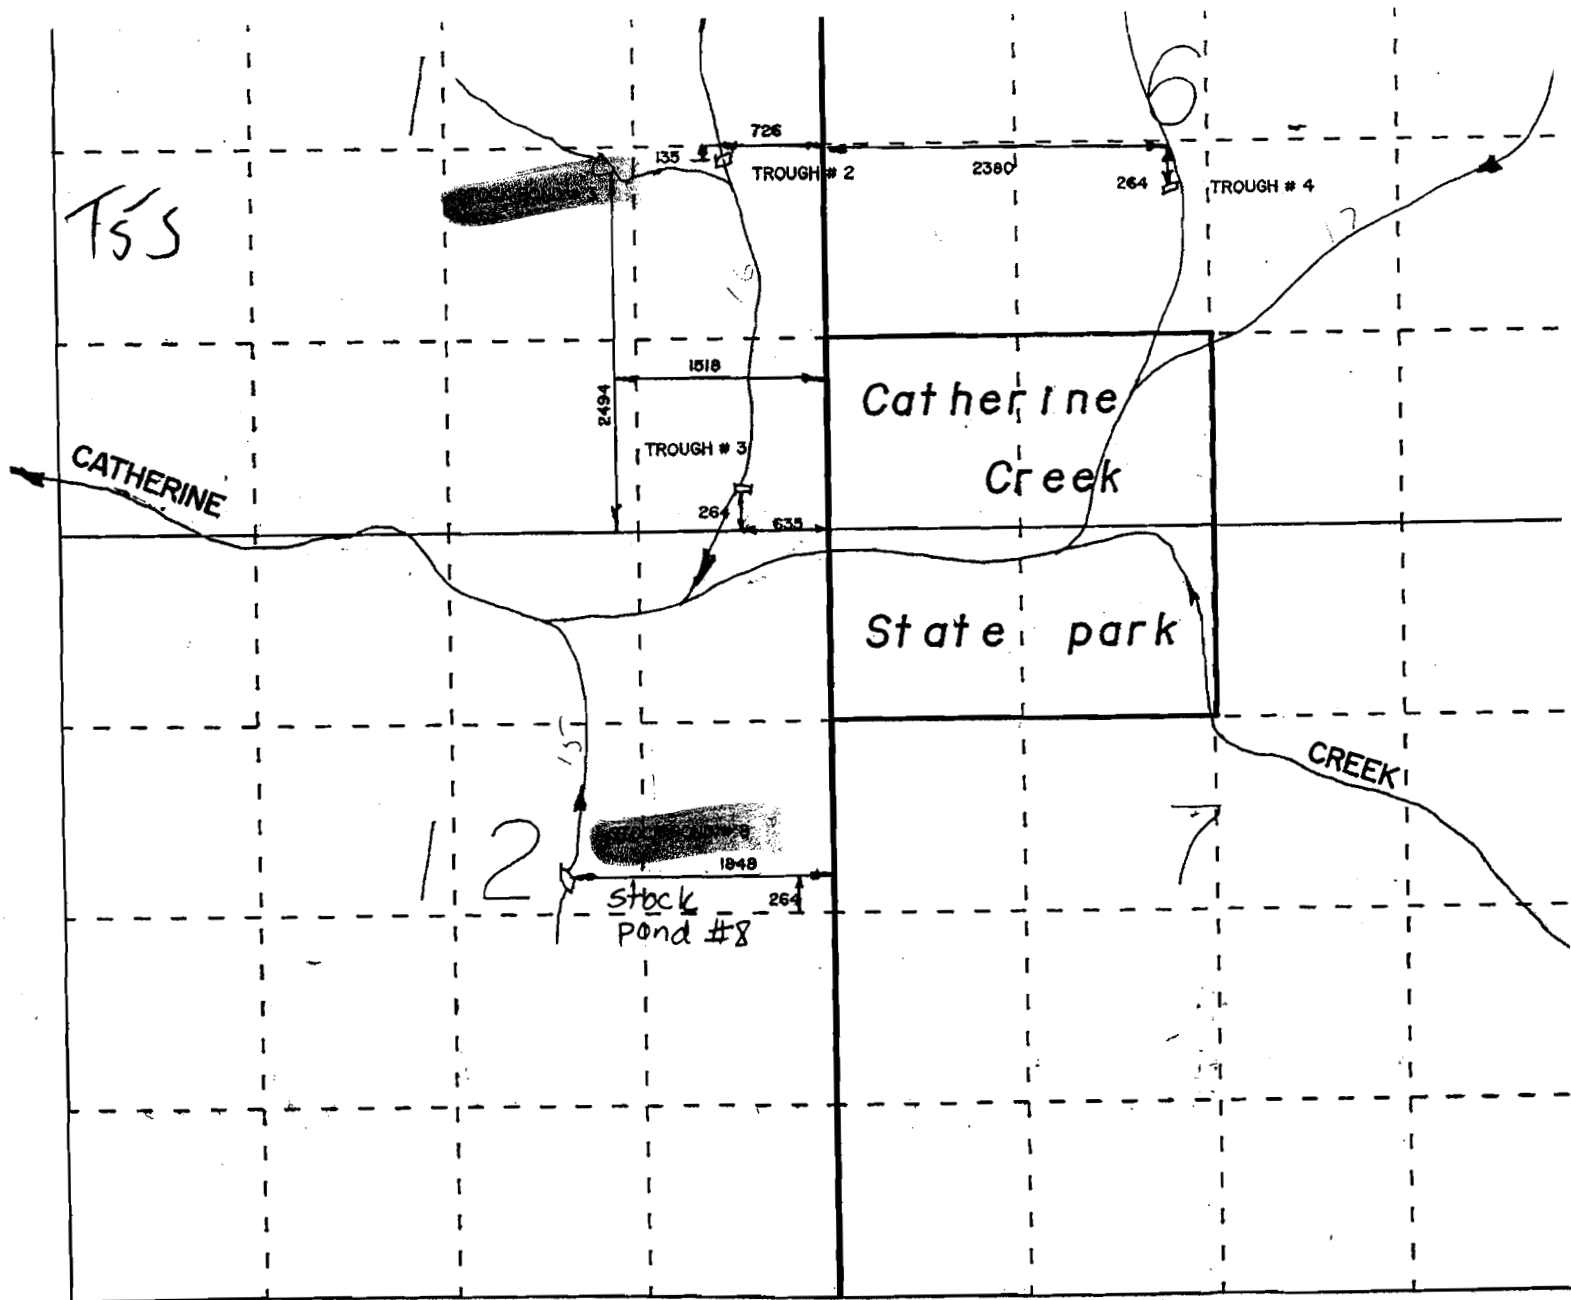

R40E

R41E