


DATE : OCTOBER 1

T 5 S

R 40 E

R 41 E

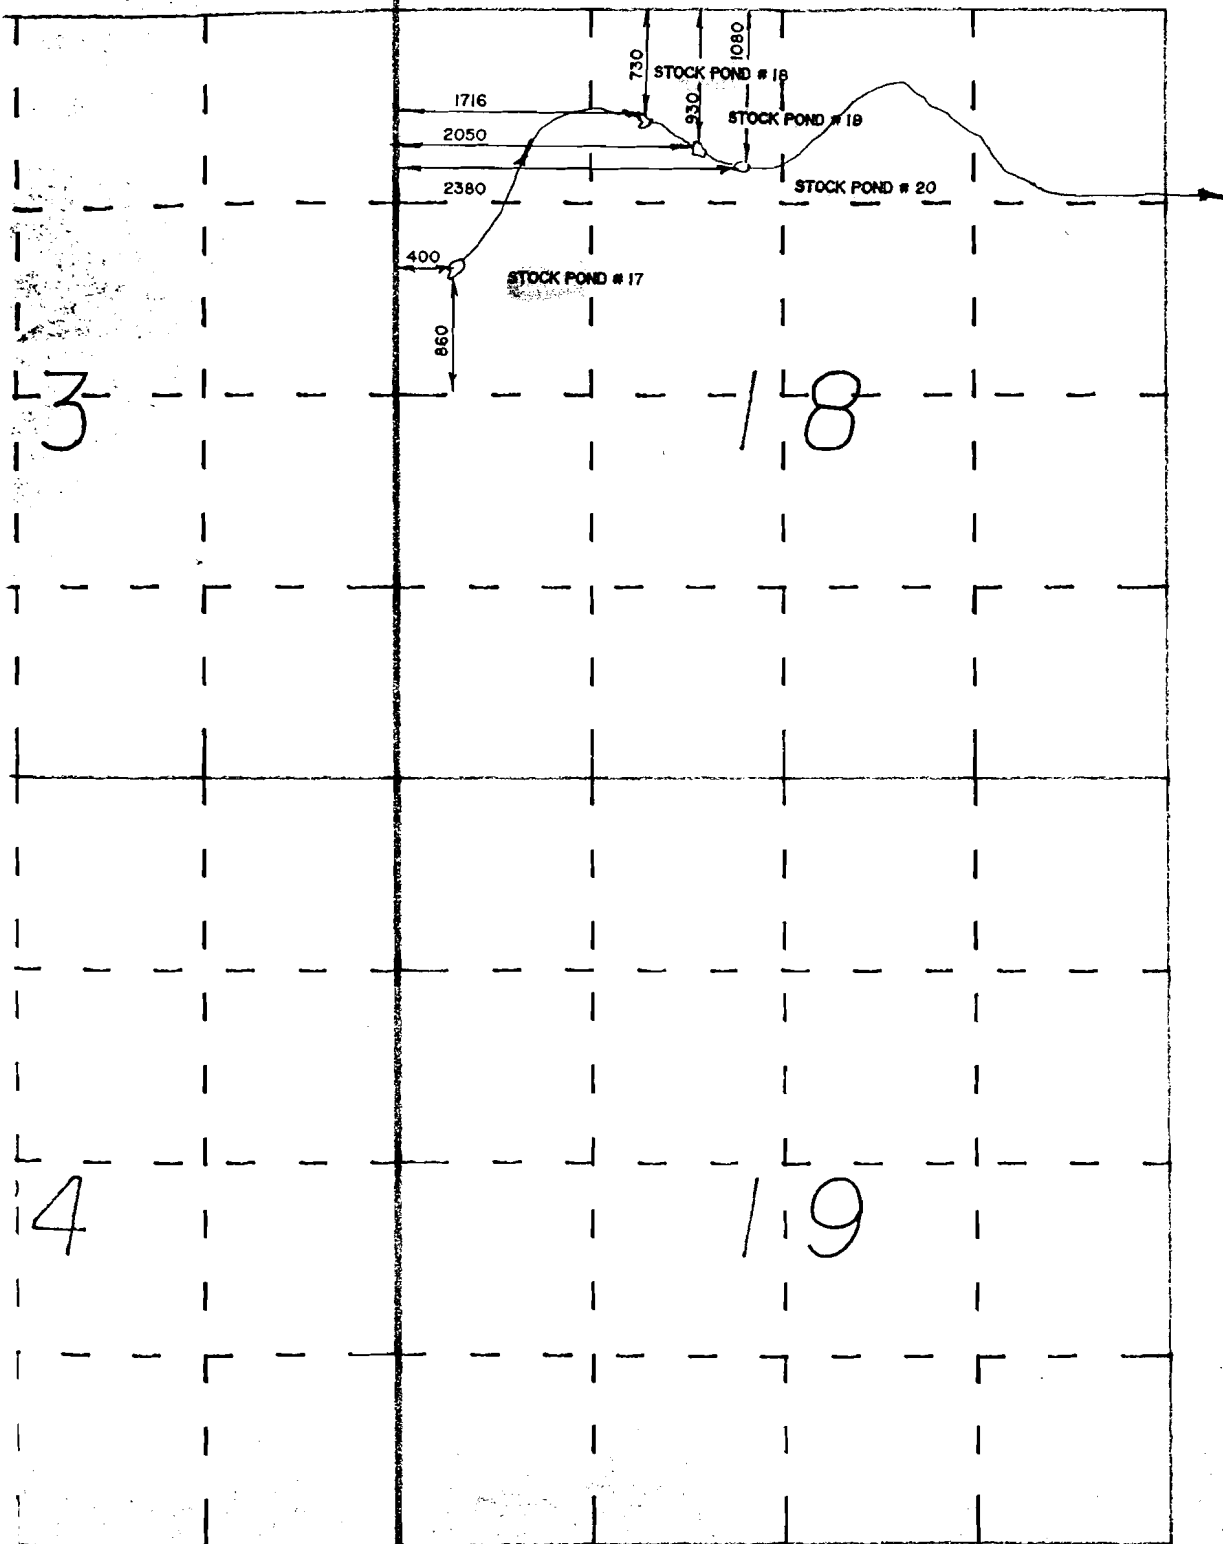

NOTE: This was for the local right of way and does not represent