
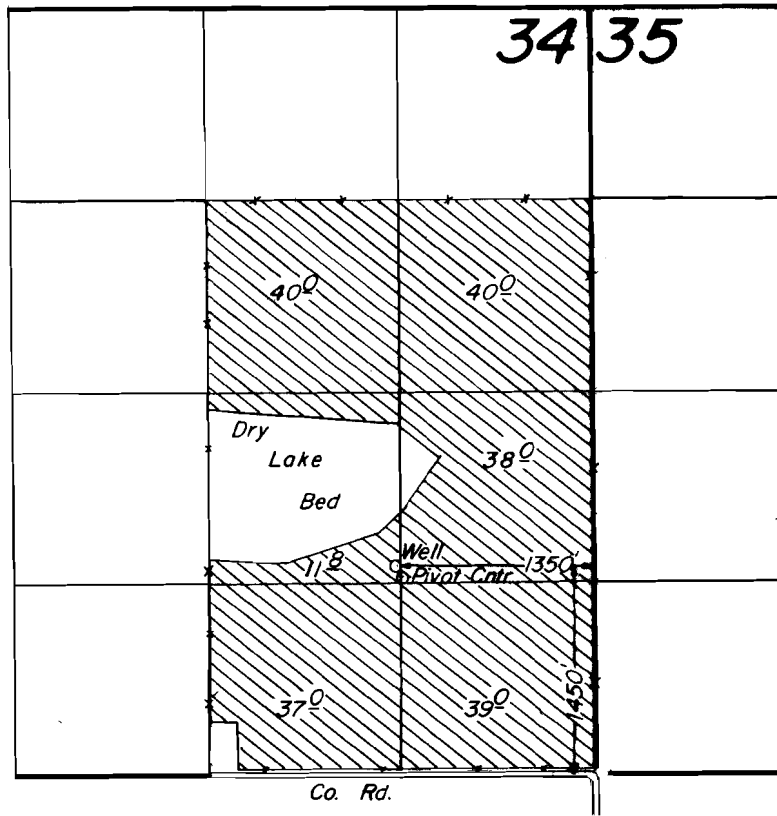


T. 26 S., R. 15 E., W.M.

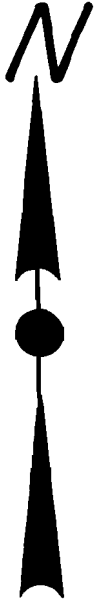

Scale : 1" = 1320'


FINAL PROOF SURVEY
UNDER

Application No. G-10095. Permit No. G-9146.....
IN NAME OF

.....**POPLARS RANCH, INC.**.....

Surveyed Oct. 11..... 1985, by T. Warren.....

T. 26 & 27 S., R. 15 E., W.M.

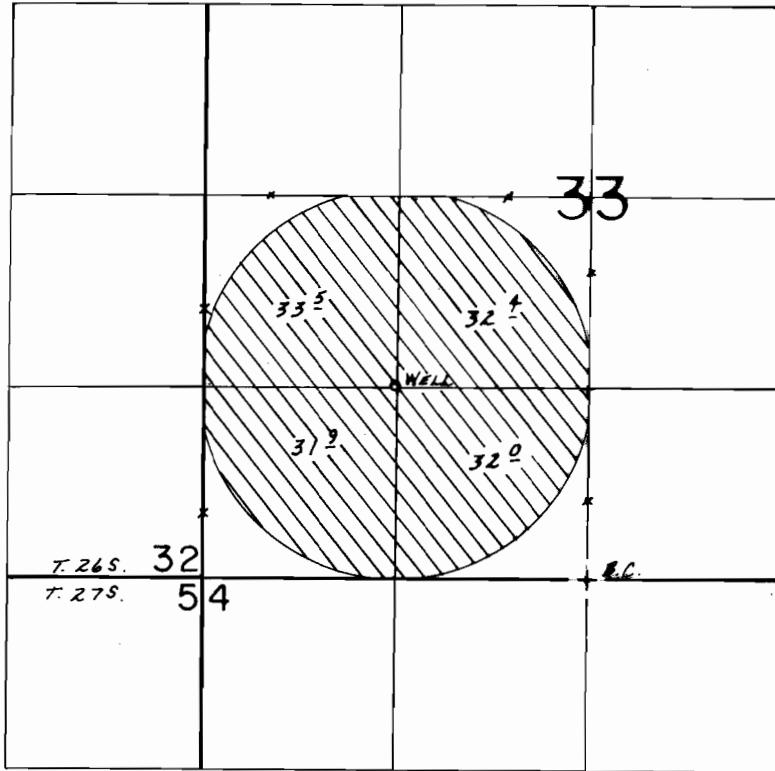

WELL LOC.: 1330' N. & 1330' W. FROM S 1/4 COR. SEC. 33.

SCALE: 1" = 1320'

FINAL PROOF SURVEY
UNDER

Transfer No. 5817

IN NAME OF

.....THE POPLARS RANCH, INC.....

Surveyed June 7, 1988, by B.W. BISHOP.....