


T. 78S., R. 39E., W.M.

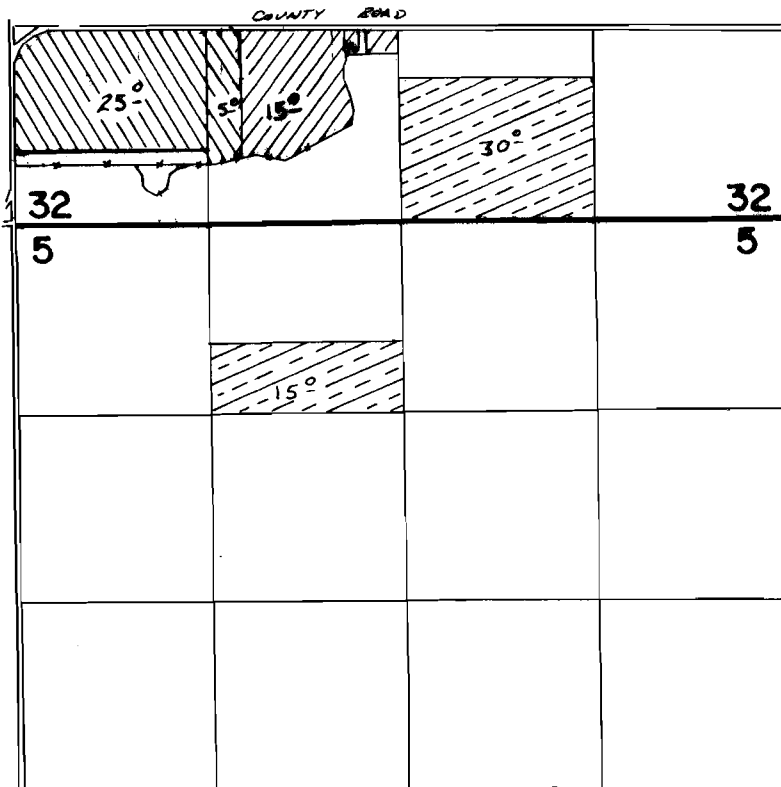

1872



1874



1880

**FINAL PROOF SURVEY**

UNDER

**TRANSFER 4315**

IN NAME OF

.....**VERNON.....HAYHURST**.....

Surveyed ~~March 29~~ 1983, by *L.L. Church*.....