

T.13S., R.30E., W.M.

TRANSFER


APPLICATION MAP FOR
EMERY & BEULAH GUNTER

RECEIVED

SEP 21 1981

WATER RESOURCES DEPT
SALEM, OREGON

T-4902

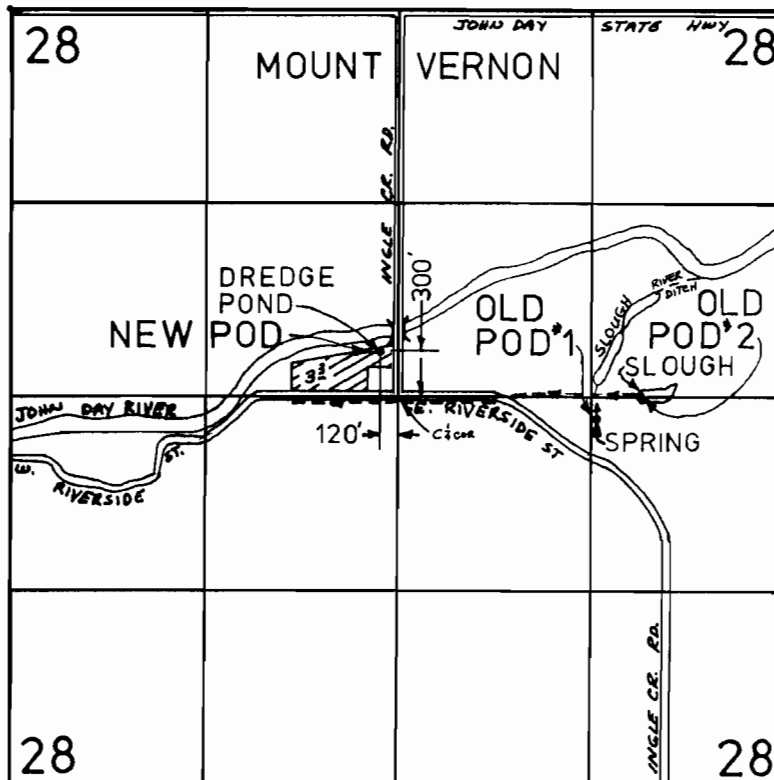

APPROVED

Emery Gunter


Beulah Gunter

OLD POD#1 is 150 ft S and 1350 ft E from center $\frac{1}{4}$ cor Sec.28

OLD POD#2 is 0 ft N and 1650 ft E from center $\frac{1}{4}$ cor Sec.28

NEW POD is 300 ft N and 120 ft W from center $\frac{1}{4}$ cor Sec.28

T.13S.,R.30E.,W.M.

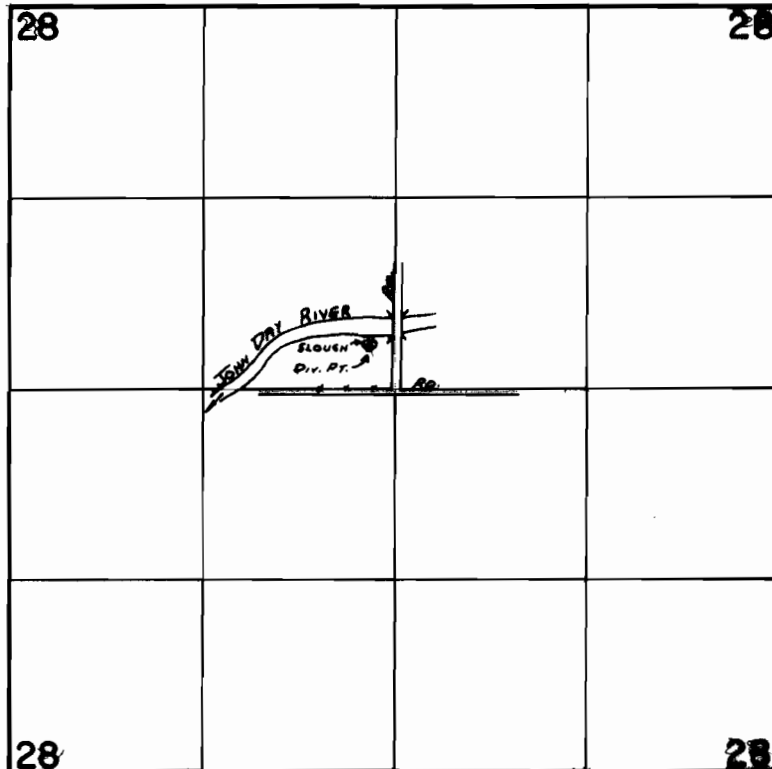

Div. Pt.: 280 ft. N and 170 ft. W from the Center of Section 28

FINAL PROOF SURVEY
UNDER

Transfer No. 4902
Application No. Permit No.
IN NAME OF

EMERY & BEULAH GUNTER

Surveyed Aug...29.. 19.83., by ..R...W...Cattel.....