


T. 29 S., R. 16 E., W.M.

FEB - 8 1994

WATER RESOURCES DEPT
SALEM, OREGON

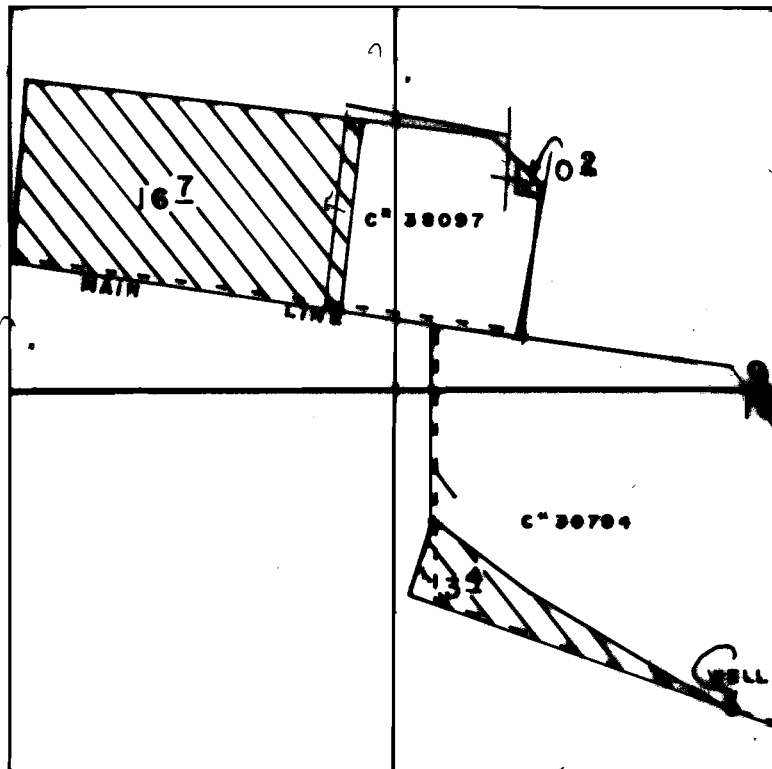

WELL LOC: 1100' S & 170' W FROM NE COR. OF SEC 16.
1140 5250' E NW

SCALE: 1" = 660'

4/8/05

FINAL PROOF SURVEY UNDER

Application No. G-10689 Permit No. G-9786
IN NAME OF

L.H.RANCH, INC.

Surveyed AUG 24, 1993, by R.M.SUTTERFIELD