


T.5S., R.3W., W.M

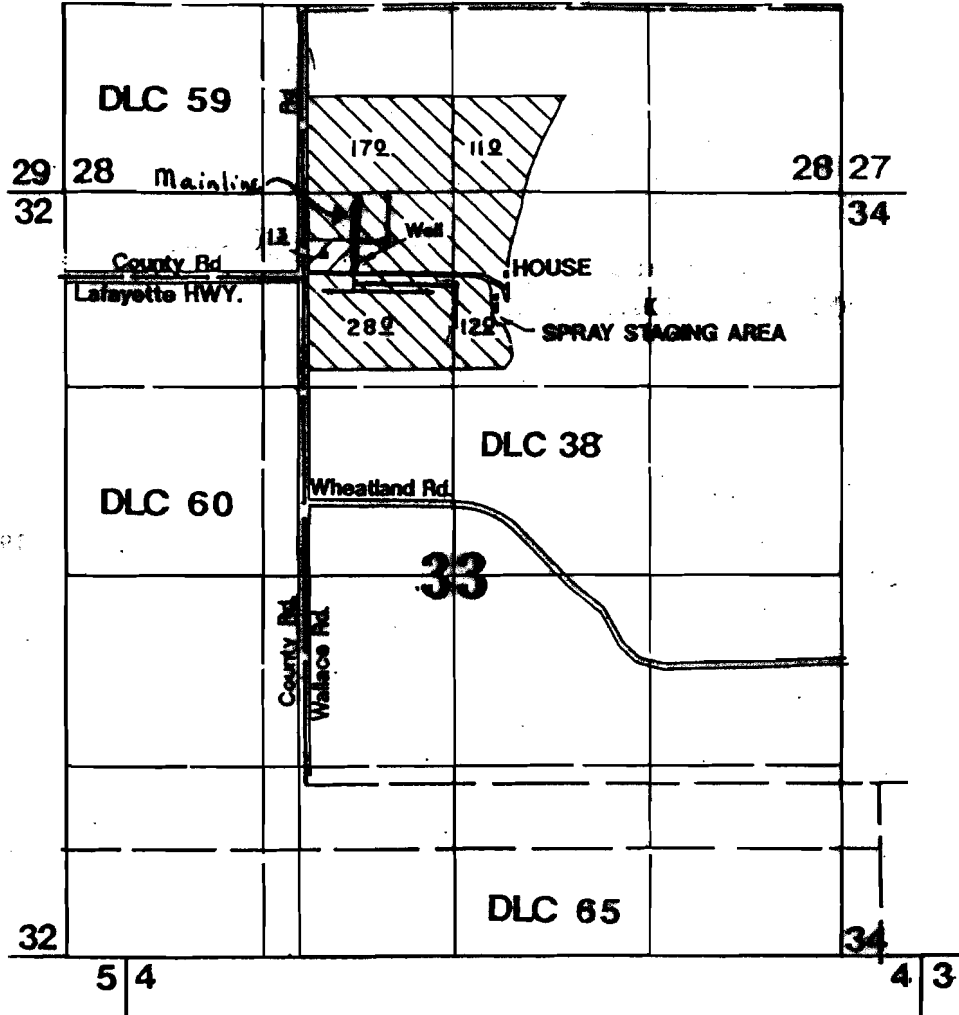


RECEIVED

MAY 03 2005

WATER RIGHTS RECEIPT DEPT SALEM OREGON

Well is located 35 feet north and 310 feet east of the NE Corner of the Adam Matheny DLC No. 60 within the NE 1/4 of the NW 1/4, as projected in D. Matheny DLC 38, Section 33, T.5S., R.3W. WM.

Application G-12474  
Permit G-12154

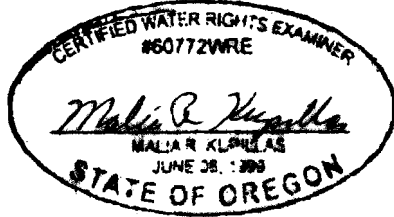

EXPIRATION DATE: 6/30/05

 Irrigation and Agricultural Use

Scale: 1" = 1,320'



0 1,320 Feet

This map was prepared for the purpose of identifying the location of a water right only and is not intended to provide legal dimensions or location of property ownership lines.



Revised Claim of Beneficial Use

Roy E. and Darlene S. Smith  
T.5S. R.3W. Portions of Sec. 28 and 33

Pacific Hydro-Geology Inc.

4/2005

Smith74COB.vxd