


G-4588

40929

T.2N.R.32E.W.M.

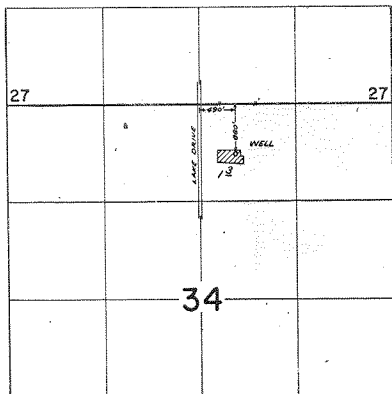

FINAL PROOF SURVEY
UNDER

Application No. G-4573 Permit No. G-4588
IN NAME OF

JACK FITTERER

Surveyed Apr. 11 1973, by D.M. NORRY