


23706
T9793
81722
81508

T.13 S.R.9 E.W.M.

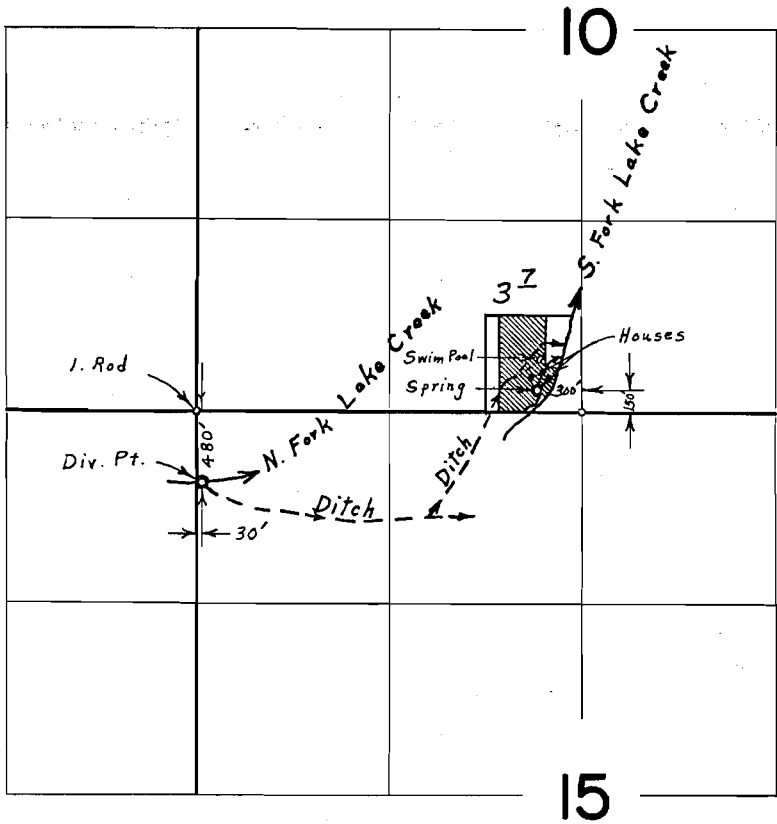

FINAL PROOF SURVEY UNDER

Application No. 29530 Permit No. 23211
IN NAME OF
JEROME L. & LENA K. HOLZMAN

Surveyed July 10, 1967. by L. E. Gould