


T. 1 N., R. 4 W., W.M.

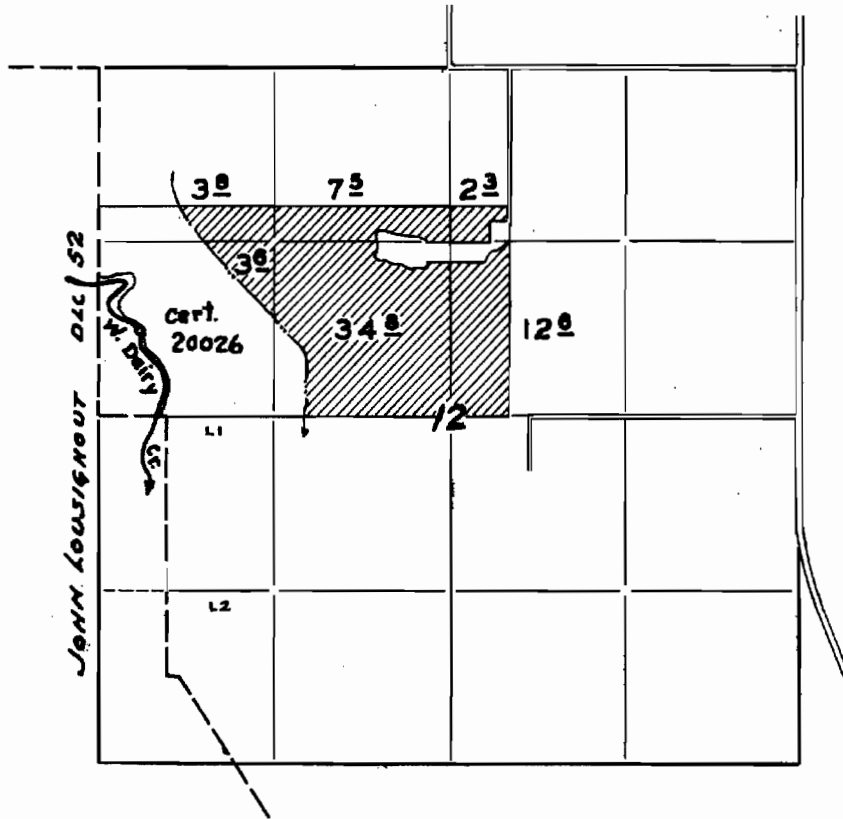

FINAL PROOF SURVEY

UNDER

Application No. 25487 Permit No. 20968

IN NAME OF

Estate of William Susbauer

Surveyed 4 - 13 1956, by R. H. Whitby.

DFR-3D-180

WC