


G 6320

48607
T9814

T. 27 S. R. 17 E. W. M.

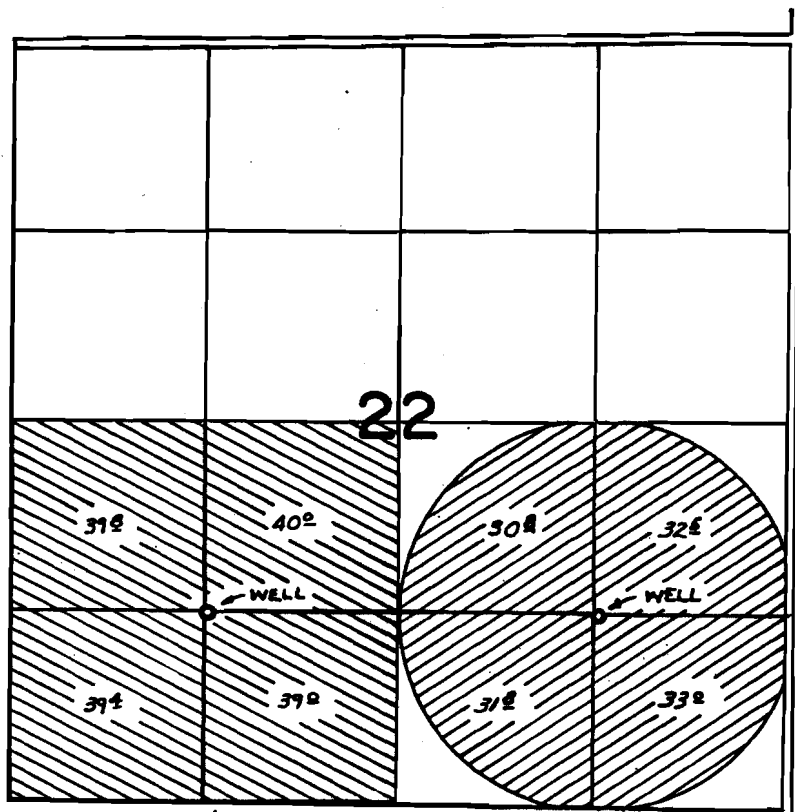

WELLS LOC: 1300' N. & 1310' W.; 1310' N. & 1340' E., BOTH FROM
S 1/4 SEC. 22

FINAL PROOF SURVEY UNDER

Application No. G-6820 Permit No. G-6320 
IN NAME OF

GOLDEN RULE FARMS, INC.

Surveyed AUG. 25, 1978, by S.P. APPELEGATE.