


G 8888
T 8020
51770
77742
T 8020
T 9814

T.27S.,R.17E.,W.M.

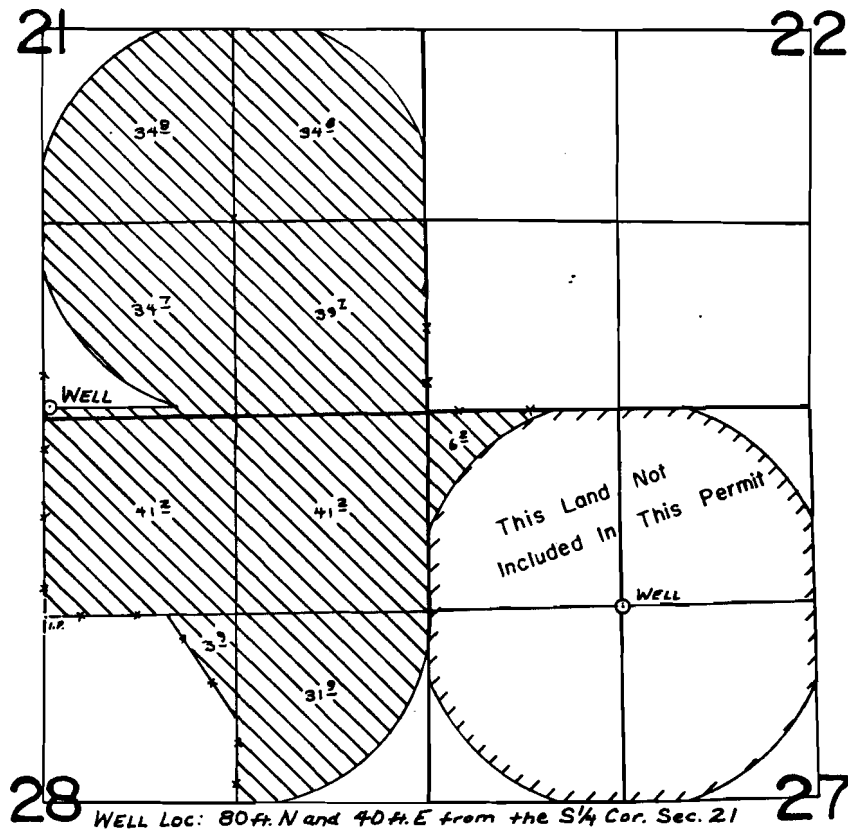

FINAL PROOF SURVEY UNDER

Application No. G-9831. Permit No. G-8888.....
IN NAME OF

.....MARVIN G. NAGELY.....

Surveyed OCT. 29, 1981., by L. TOLL.....