


T.35S., R.1W., W.M.

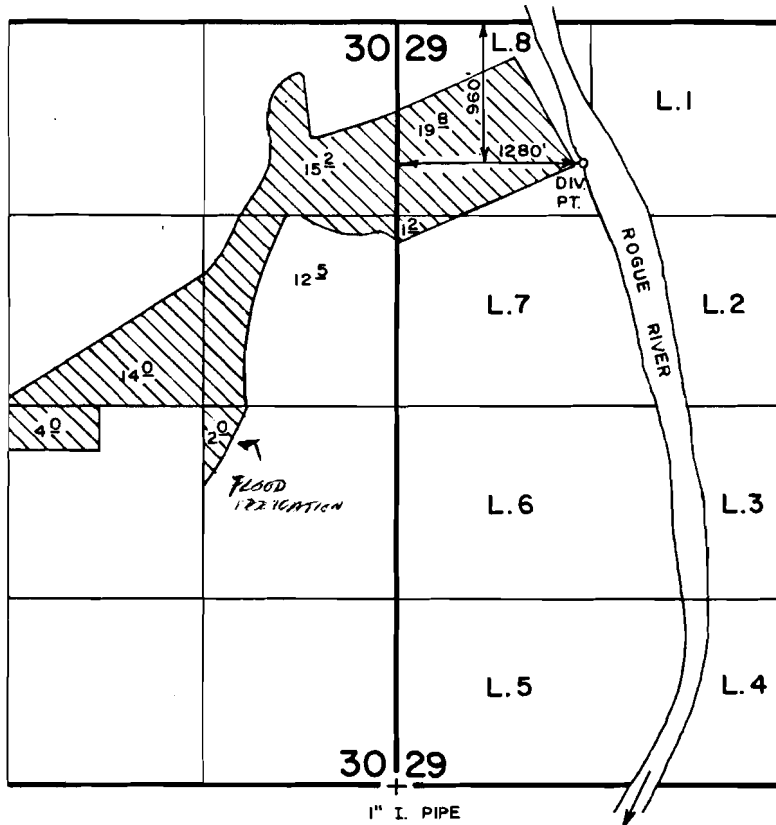

**FINAL PROOF SURVEY**  
UNDER

Application No. 52997 Permit No. 40004  
IN NAME OF

EDWARD R. STUEDLI

Surveyed JULY 12, 1983, by B. S. JAMES

SCALE: 4" = 1 MILE

by