


T 1 N R 38 E

CRAIG LOOP

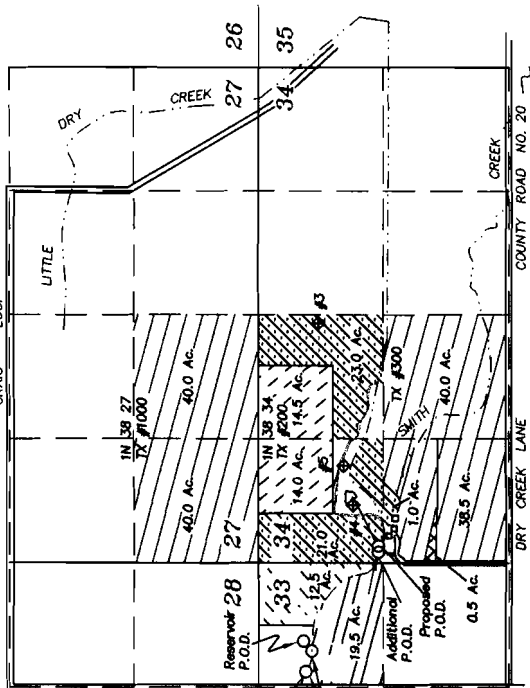

1"=1320'

Authorized P.O.D.s 1-2

Reservoir 28 P.O.D.

33

34

Lands irrigated by Certificate 36805 and 46910, owned by others.

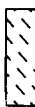

Lands irrigated by Certificate and 46910, owned by others.



Lands irrigated by Certificate 6453 Smith (1883 Priority) requesting change in P.O.D. (Northwest corner of Section 34) along with change of place of use.

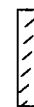

Lands irrigated by Certificate 36805 (0.5 Acres) requesting a change in point of diversion.



Lands irrigated by Permit 46910 requesting change in P.O.D. and additional P.O.D. along with a change of Place of use.



Lands irrigated by Primary Certificate 36804 priority 1964, and supplemental Certificate 46910 requesting change of P.O.D. and consolidating P.O.D.s (surplus) along with change in place of use.



Authorized P.O.D.#1 is located 1150' West and 500' South of the Northwest corner of Section 34.

Authorized P.O.D.#2 is located 550' South and 930' West of the Northwest of Section 34.

Point of Diversion from n Reservoir is located 475' South and 825' West of the Northwest corner of Section 34.

SUPERSEDING
March 28, 2005

APPLICATION MAP FOR CHANGE OF POINT OF DIVERSION- PLACE OF USE ADDITIONAL POINT OF DIVERSION AND ADDITIONAL POINTS OF APPROPRIATION