


TOWNSHIP 18 SOUTH, RANGE 17 EAST, W.M.

- ⊗ C-11097
27± acres
- ⊙ C-11097
6± acres
Abandoned

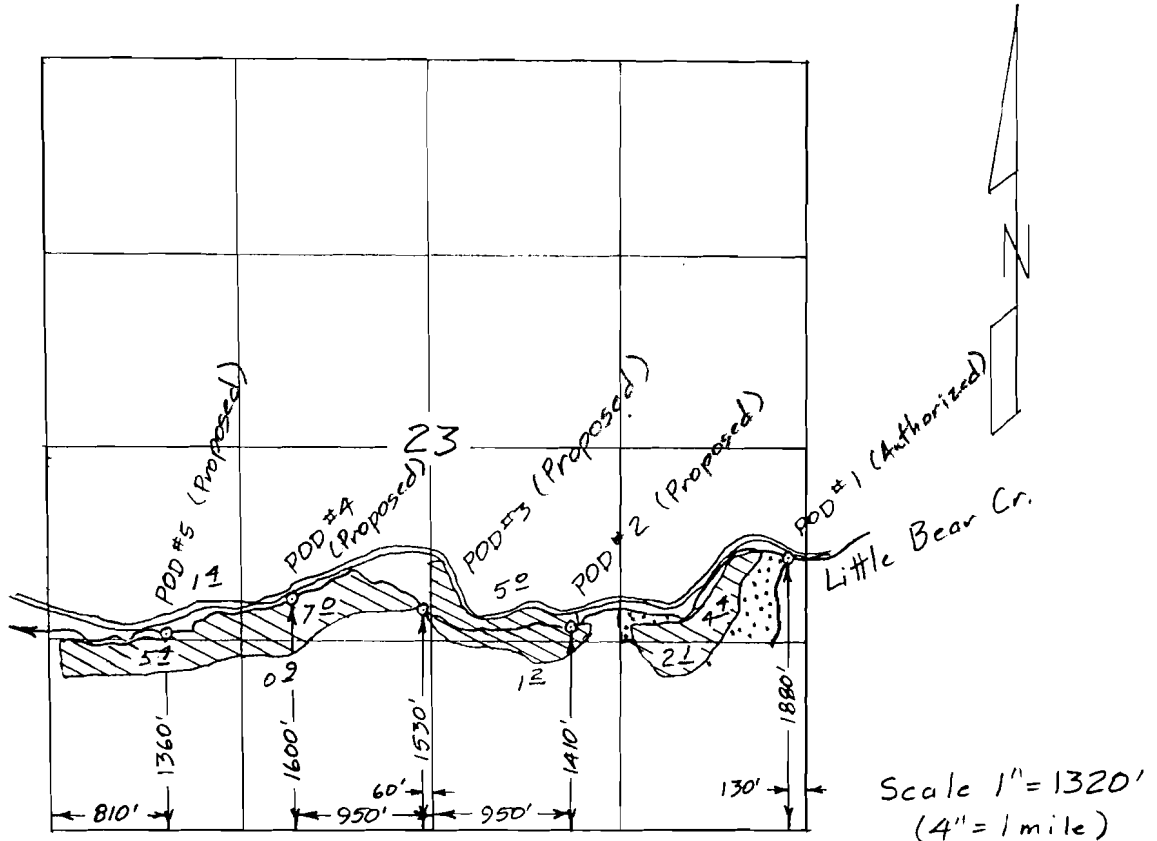

Surveyed July 22, 2004

Claim of Beneficial Use Map
for
J.W. Hart, Sagehollow Ranch

RECEIVED
MAY 18 2005
WATER RESOURCES DEPT
SALEM, OREGON

Certified Water Right Examiner
#1
Bruce A. Estes
Bruce A. Estes
Nov. 19, 1987
STATE OF OREGON

Renewal Dec 31, 2005
Sheet 2 of 2

This map is for the purpose of
locating a water right only
and has no intent to provide
legal dimensions or the location
of property lines.

ESTES SURVEYS, LLC
PO Box 17519 · 60382 Arnold Rd
Salem, OR 97305-7519 Bend, OR 97702
(503) 585-7593 (541) 382-7391

2 Feb 05