— Original —

T. 6 S., R. 1 E., W.M.

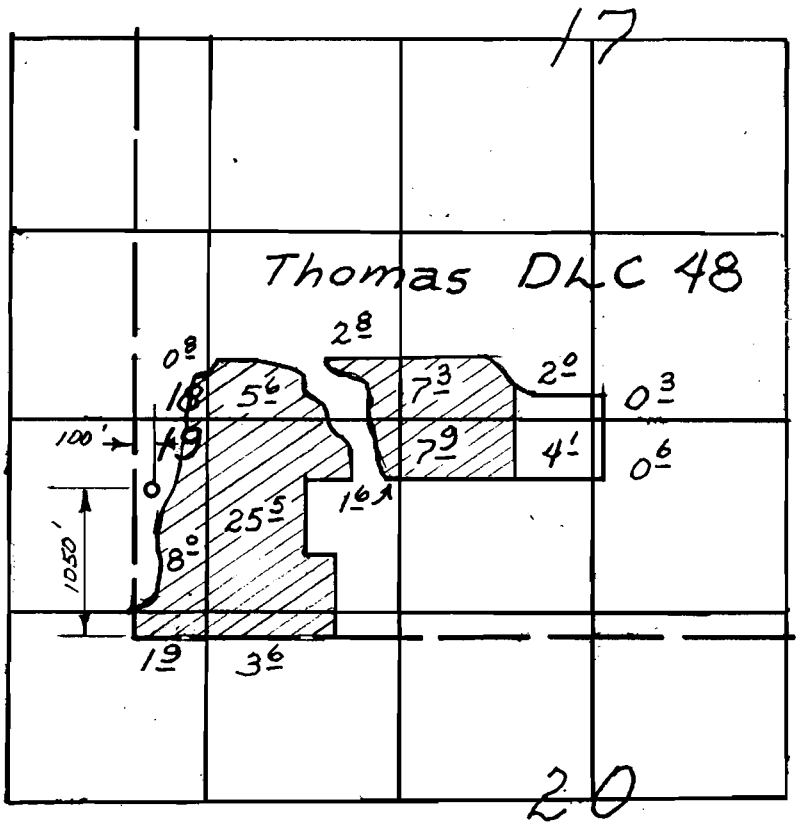

Scale 1" = 1320'

FINAL PROOF SURVEY
UNDER

Application No. G10943 Permit No. G10100

IN NAME OF

David J. Bielenberg

Surveyed June 2, 1988 by Z. Saleh

15 MAR 05 dlb