


**T. 29 S., R. 4 W., W. M.**

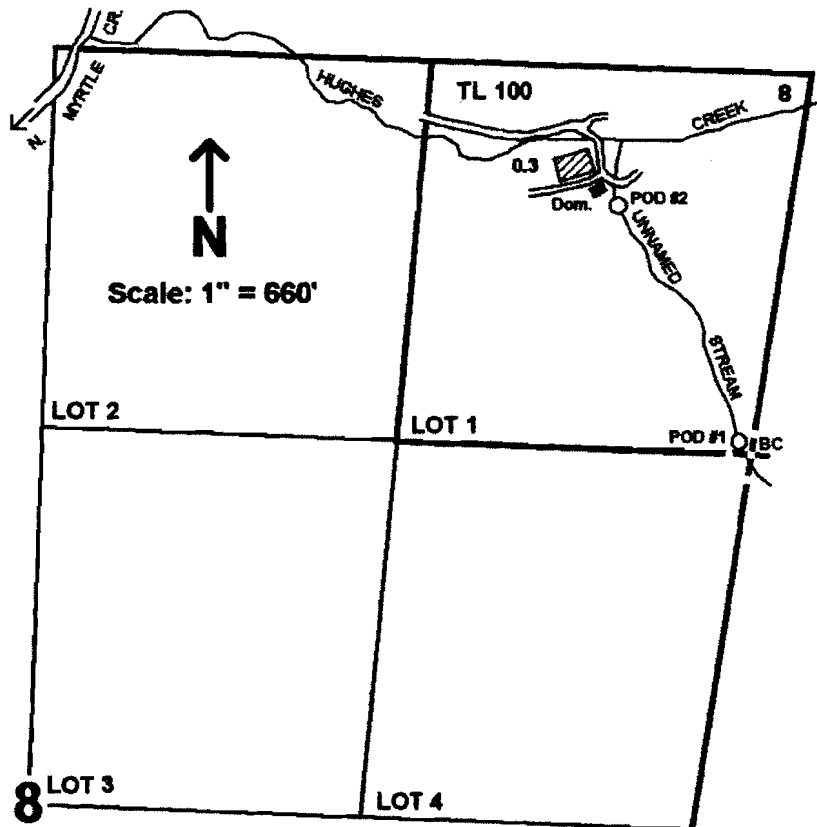

POD #1 - 40 ft. N. and 50 ft. W. }  
from the N 1/16 corner between Sec. 8 and 9  
POD #2 - 845 ft. N. and 450 ft. W. }

**FINAL PROOF SURVEY**  
**UNDER**

Application No. 61046 Permit No. 45441

IN NAME OF

GERALD A. WHITE Sr.

Surveyed July 13 1995, by D. R. Henry