


T.35S., R.33E., W.M.

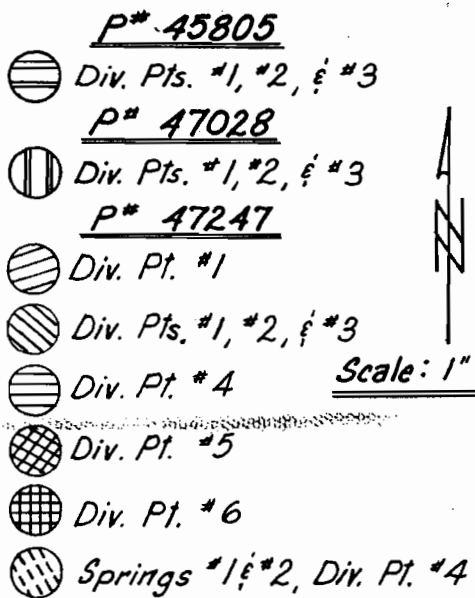

Scale: 1" = 1320'

FINAL PROOF SURVEY


UNDER

Application No. **61548** Permit No. **45805**
62824 **47028**
62823 **47247**

IN NAME OF

WILDHORSE RANCH, INC.

Surveyed 7-17 1988, by Vern Church

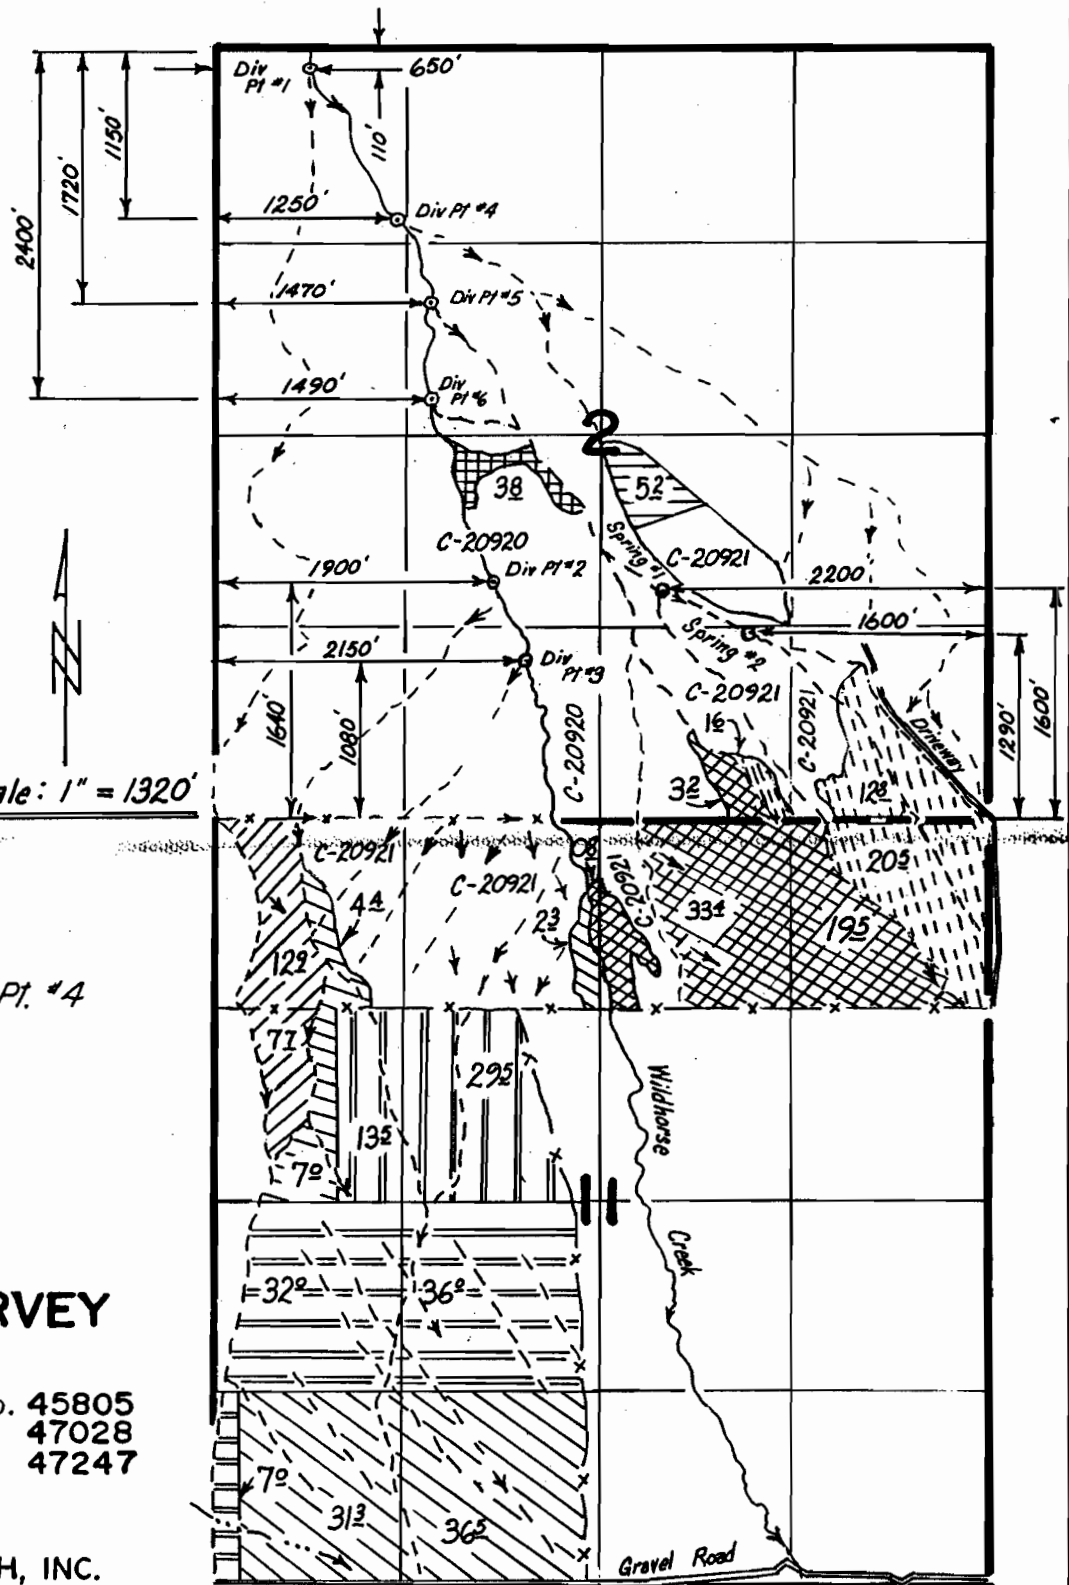

41025-579-257L KK 1/89