


T.35S., R.33E., W.M.

- P* 45805
 Div. Pts. #1, #2, & #3
P* 47028
 Div. Pts. #1, #2, & #3
P* 47247
 Div. Pt. #1
 Div. Pts. #1, #2, & #3
 Div. Pt. #4
 Div. Pt. #5
 Div. Pt. #6
 Springs #1 & #2, Div. Pt. #4

Scale: 1" = 1320'

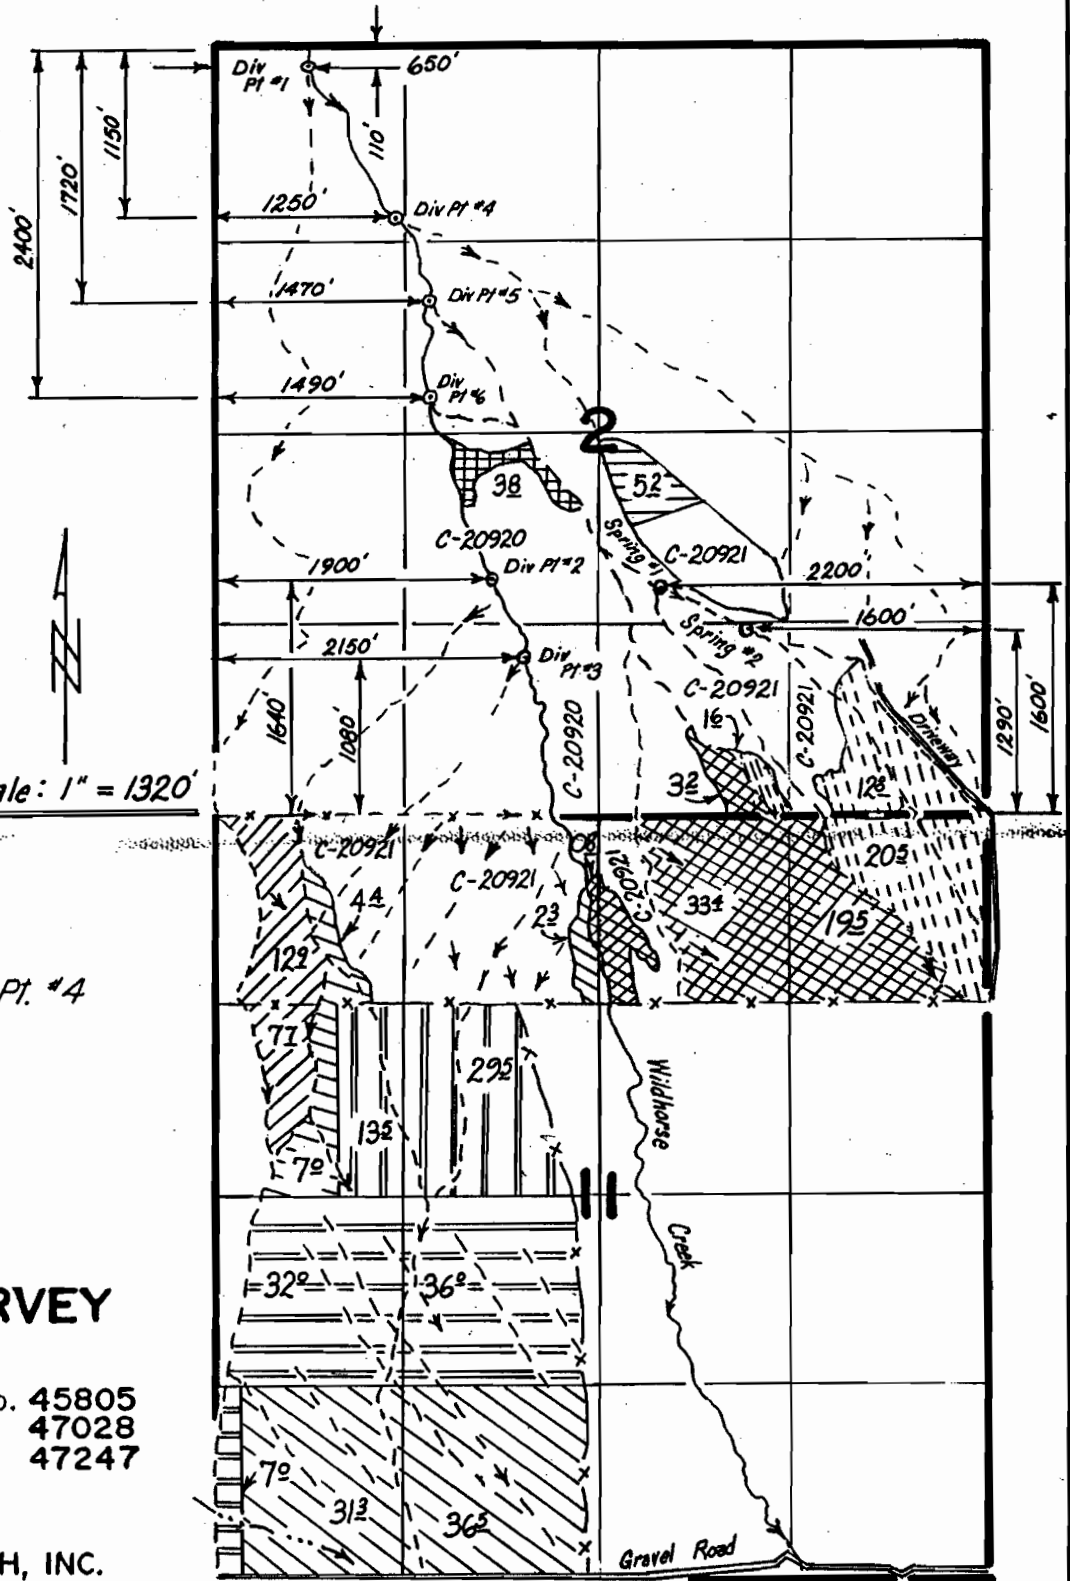

FINAL PROOF SURVEY

UNDER

Application No. 61548 Permit No. 45805
 62824 47028
 62823 47247

IN NAME OF

WILDHORSE RANCH, INC.

Surveyed 7-17 1988, by Vern Church

41025-579-257L KK 1/89