


T.35S., R.33E., W.M.

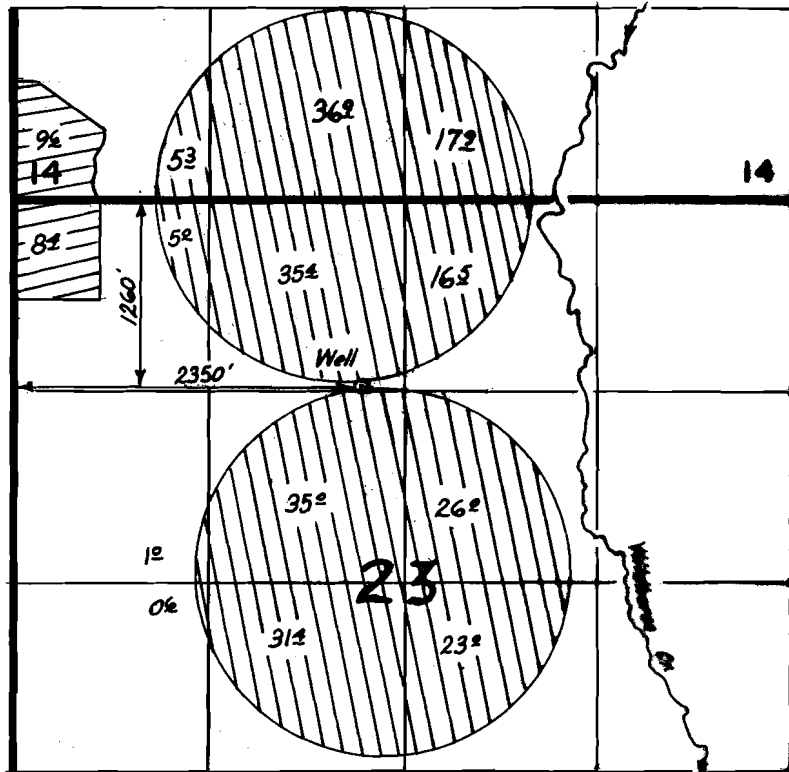

Scale : 1" = 1320'

**FINAL PROOF SURVEY**  
UNDER

**TRANSFER 3850**

Application No. G-8379, Permit No. G-8052  
IN NAME OF

.....WILD HORSE RANCH, INC.....

Surveyed 7-17, 1988, by Vern Church.....



P# G-8052



Transfer 3850