


T.35S., R.33E., W.M.

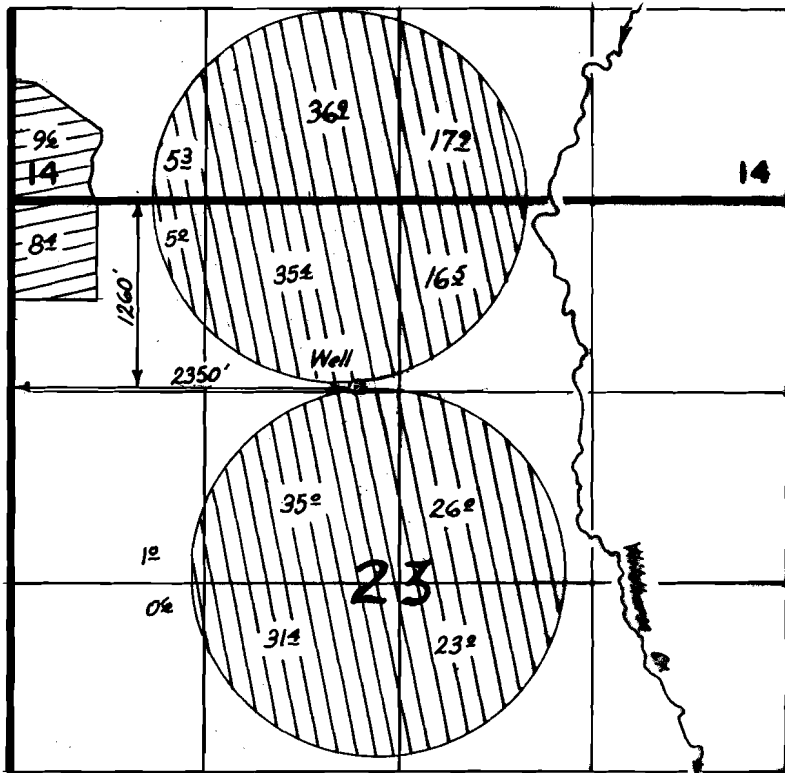

Scale : 1" = 1320'

FINAL PROOF SURVEY

UNDER

TRANSFER 3850

Application No. G-8379 Permit No. G-8052

IN NAME OF

.....**WILD HORSE RANCH, INC.**.....

Surveyed ...7-17... 1988, by Vern Church.....



P# 6-8052



Transfer 3850