

CLAIM OF BENEFICIAL USE MAP



APPLICATION: S-74086

PERMIT: 53047

FOR

PERNOLL RANCH, LLC

LOCATED WITHIN SECTIONS 34 AND 35
TOWNSHIP 29 SOUTH, RANGE 17 EAST, W.M., AND
IN SECTIONS 2 AND 3
TOWNSHIP 30 SOUTH, RANGE 17 EAST, W.M.,
LAKE COUNTY, OREGON

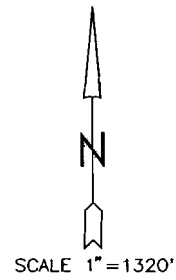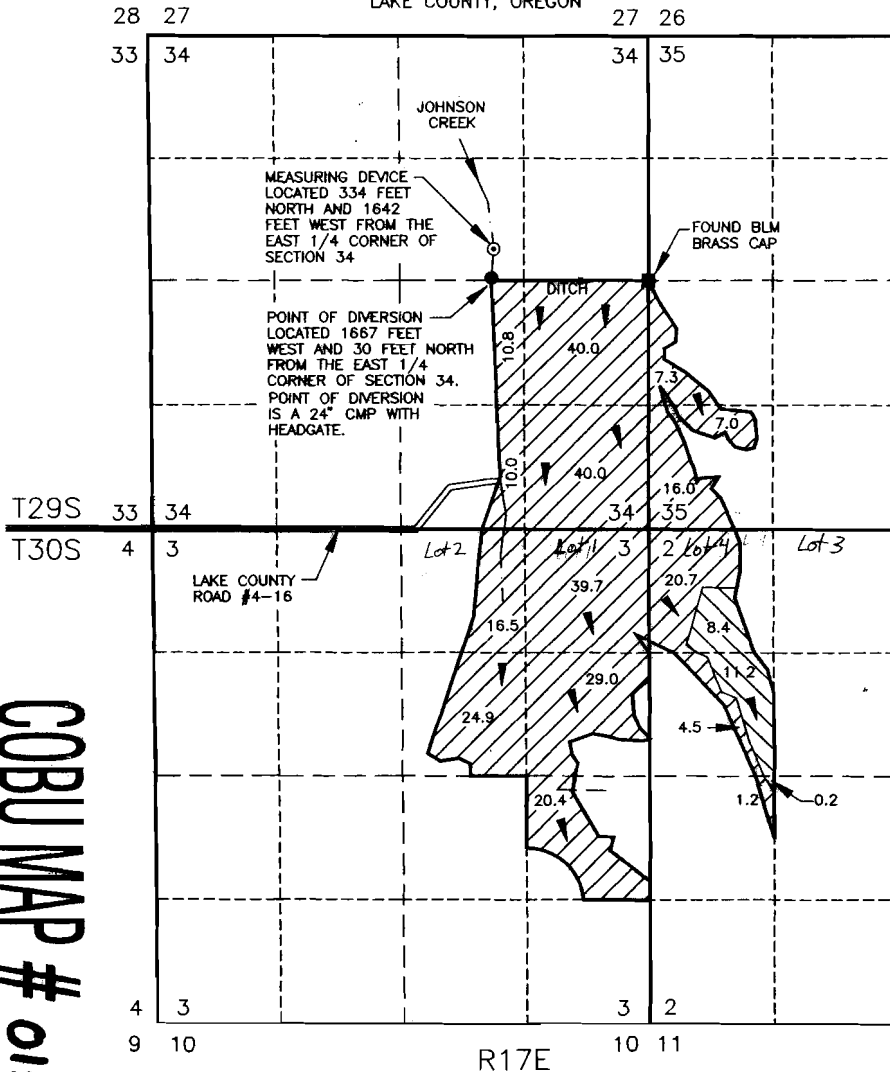

LEGEND



288.0 ACRES BEING IRRIGATED AS
PER PERMIT 53047.



19.8 ACRES BEING IRRIGATED
SUPPLEMENTAL TO
CERTIFICATE #33024.

● EXISTING POINT OF DIVERSION.

■ FOUND LAND SURVEY
MONUMENT AS NOTED.

⊙ EXISTING MEASURING DEVICE.

COBU MAP # 0158



RE-NEW: 12/31/03

THIS MAP IS FOR THE PURPOSE OF LOCATING A
WATER RIGHT ONLY AND HAS NO INTENT TO PROVIDE
LEGAL DIMENSIONS OR THE LOCATION OF
PROPERTY LINES.

RECEIVED

AUG 07 2003

WATER RESOURCES DEPT.
SALEM, OREGON

PREPARED FOR: PERNOLL RANCH, LLC
705 GREENSBURG CIRCLE
RENO, NV 89509

PREPARED BY:

CLS

CALLAGHAN LAND SURVEYING
427 SOUTH H STREET
LAKEVIEW, OR 97630
(541) 947-5841

DATE: 7/23/2003 DRAWING: 200301

6/9/2005 Lot #s added to map JLC WRD