


T. 13 E. W. M.

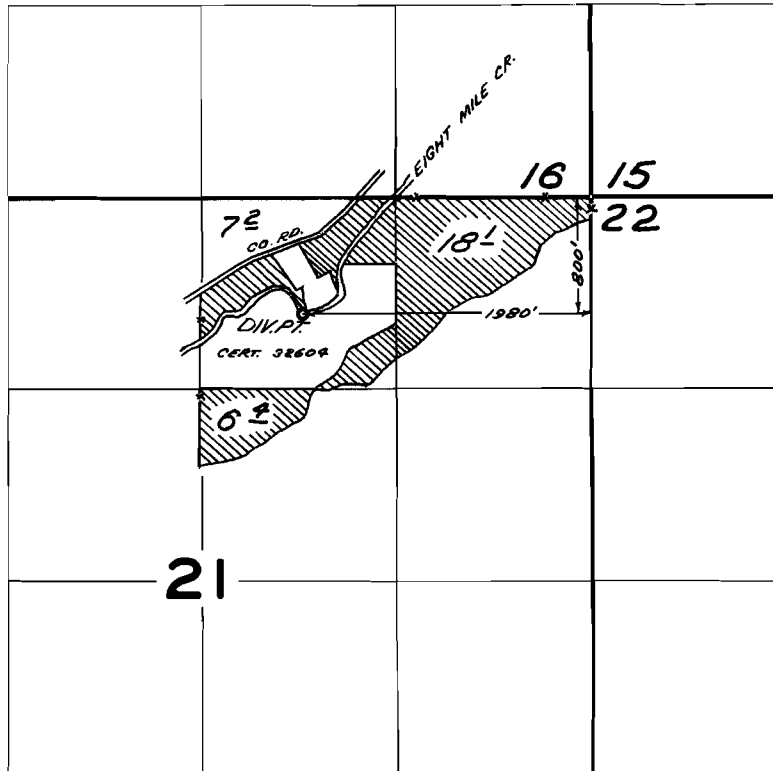

FINAL PROOF SURVEY
UNDER

Application No. 40071 Permit No. 29863
IN NAME OF

ARTHUR AND ELIZABETH APPLING

Surveyed Nov. 16 1967, by W. J. RUPPERT