


Per 25409  
33055

T.9S.R.32E.W.M.

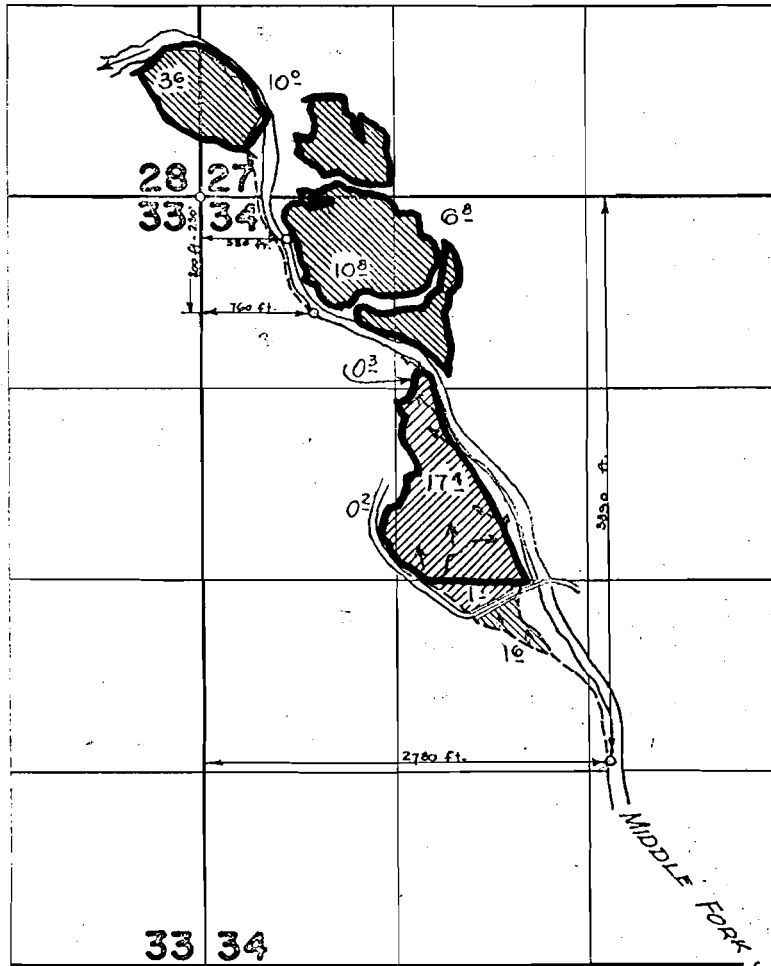

Acres of  
Water Right  
To Be Cancelled

Primary  
Supplemental

FINAL PROOF SURVEY  
UNDER

Application No. 32158..... Permit No. 25409.....  
IN NAME OF

PHILIP W. MURPHY

Surveyed Oct. 22 1964, by *R. Johnson*

RECEIVED  
JUL 08 2005  
WATER RESOURCES DEPT  
SALEM, OREGON