


P- 25442

T.9S.R.32E.W.M.

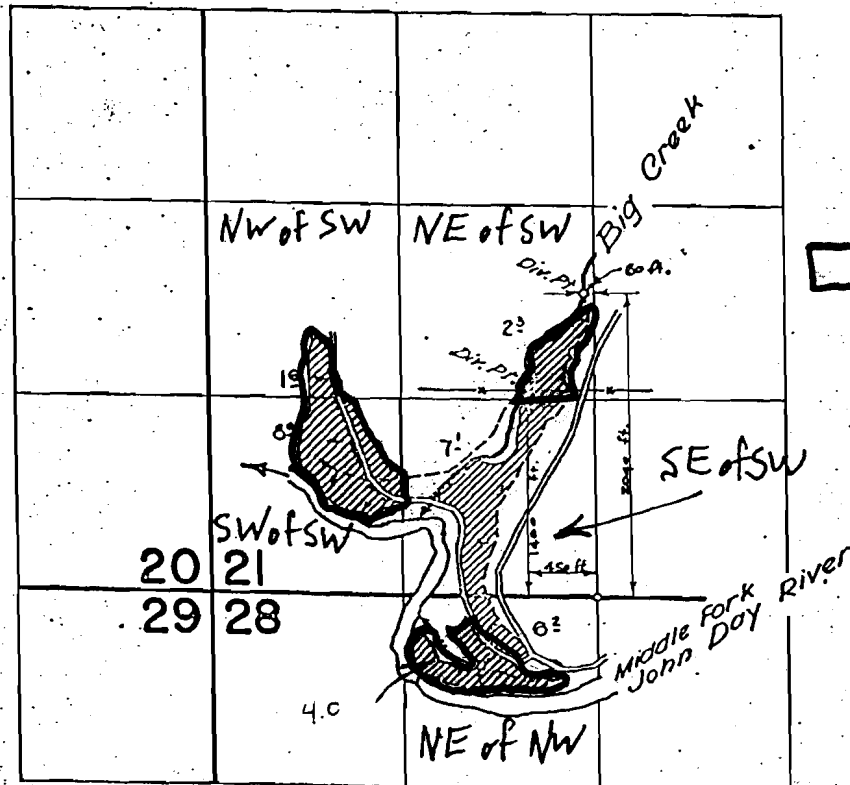

 = Acres of Water Right To Be Cancelled

FINAL PROOF SURVEY
UNDER

Application No. 32252... Permit No. 25442...
IN NAME OF

PHILIP W. MURPHY

Surveyed Oct. 21, 1964, by

by W. H. Jackson

RECEIVED

JUL 08 2005 .

WATER RESOURCES DEPT
SALEM, OREGON