
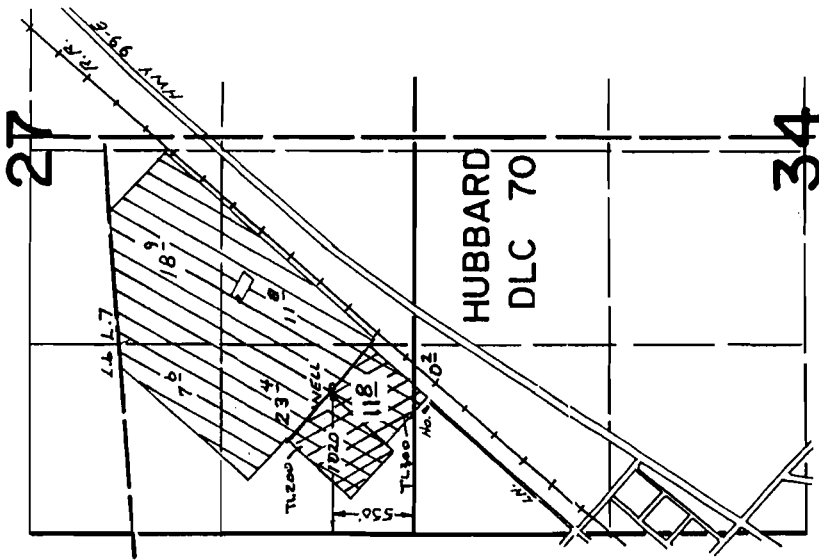


TRANSFER APPLICATION MAP
 In the name of Louis F. DouBrava


Sections 32 & 33, T 4 S R 1 W, WM
 TO LAND

Section 27, T 4 S R 1 W, WM
 FROM LAND

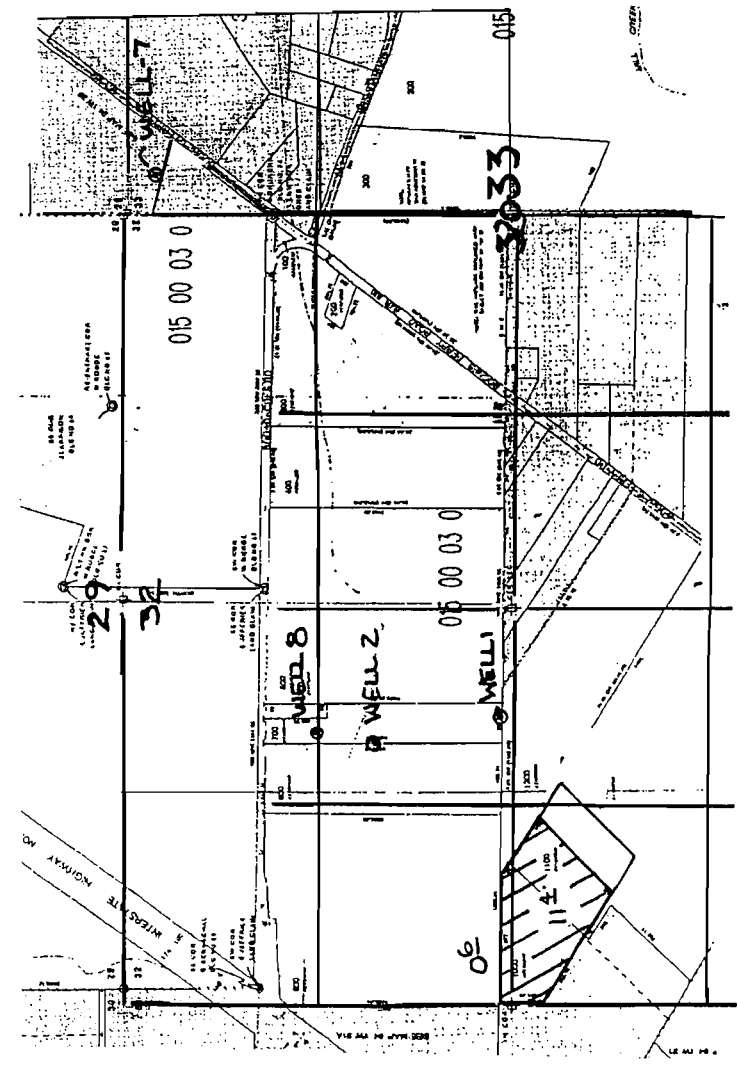

- Well # 1: 60' N and 1950' E from the W 1/4 corner sec. 32
- Well # 2: 980' N and 1650' E from the W 1/4 corner sec. 32
- Well # 8: 1350' N and 1860' E from the W 1/4 corner sec. 32
- Well # 7: 770' N and 250' E from the NE Corner DLC 56

Scale 1" = 1320'

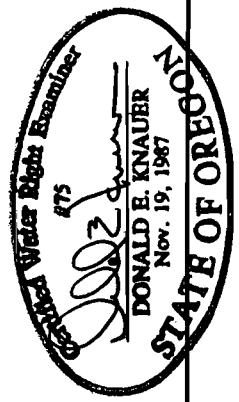

0891-T