


**T12 & 13S. R4W. WM.**

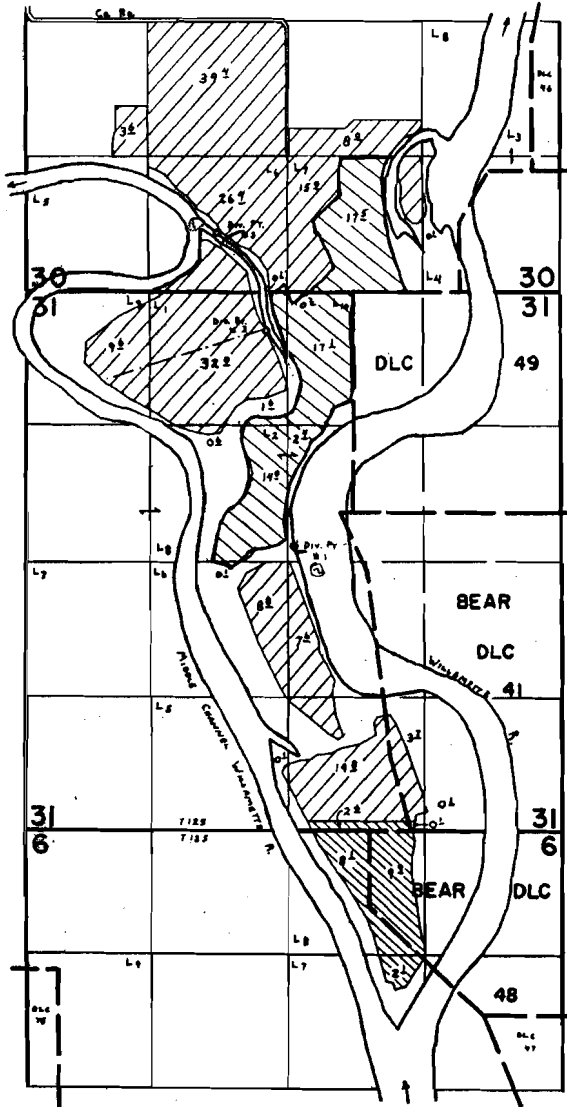

Div. Pts. Locs:  
 #1 - 2790' N. & 2580' E. fr. S.W. Cor. Sec. 31.  
 #2 - 3000' S. & 200' W. } BOTH fr. C. 1/4 Cor. Sec. 30.  
 #3 - 2060' S. & 690' W. }  
 [Hatched Box] - PRIMARY APP. #3167 SUPPLEMENTAL APP. #5260  
 [Diagonal Lines] - PRIMARY APP. T-3851 SUPPLEMENTAL APP. #5260  
 [Cross-hatched Box] - PRIMARY APP. #5260

**FINAL PROOF SURVEY  
 UNDER**

T-3851  
 55260. 43137  
 Application No. ~~53167~~ Permit No. ~~40045~~  
 IN NAME OF

**ROY HATHAWAY**

Surveyed Oct. 3, 1979, by G. L. HUGHES