


T. 6 N. R. 35 E. W. M.

■ To be Canceled Supl. 3 acres

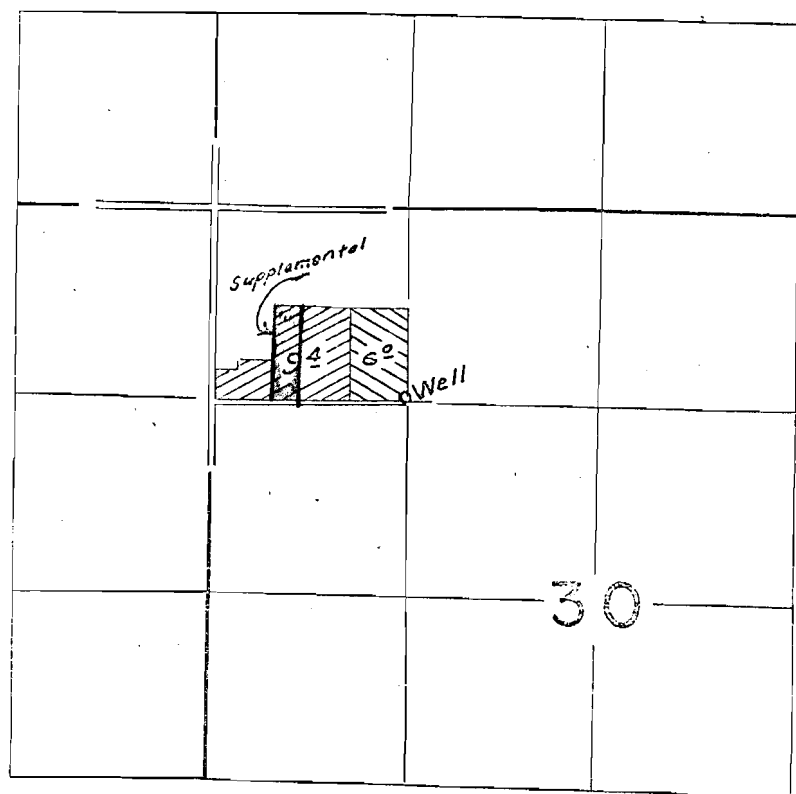

RECEIVED

MAR 02 2005

WATER RESOURCES DEPT
SALEM, OREGON

FINAL PROOF SURVEY UNDER

Application No. G-2485 Permit No. G-2295
IN NAME OF

ESTATE OF A. L. HAND

Surveyed April 18, 1964, by R. Jackson