


T.9S.R.32E.W.M.

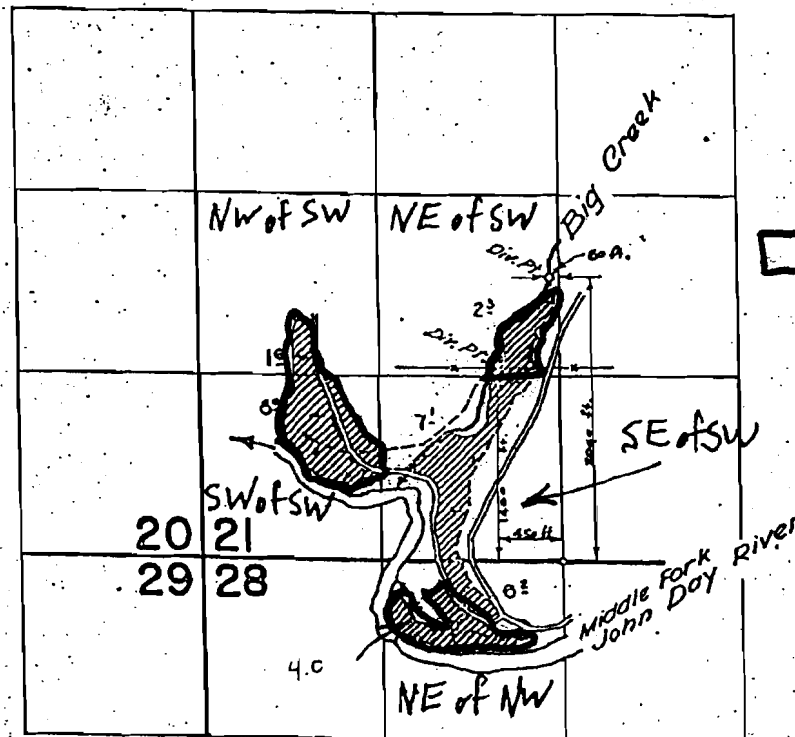

FINAL PROOF SURVEY
UNDER

Application No. 32252... Permit No. 25442...
IN NAME OF

PHILIP W. MURPHY

Surveyed Oct. 21, 1964, by

[Signature]

RECEIVED

JUL 08 2005

WATER RESOURCES DEPT
SALEM, OREGON