

River

X-X: Location sketched from township maps.


2

2 N, R. 11 E., W.M.

0.67-1924
D. 1924

City Reservoir

0.4-1948

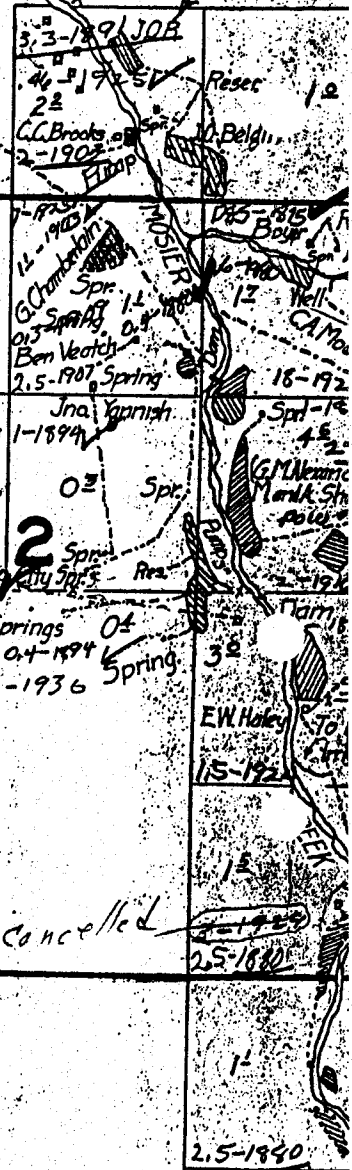

Lawyers Trust Co.
1310 Yeon Portland
(J.E. Folsom)
T.T. Dobney
2.5-1908

Cancelled

11

14

13