


TOWNSHIP 18 SOUTH, RANGE 10 EAST, W.M.

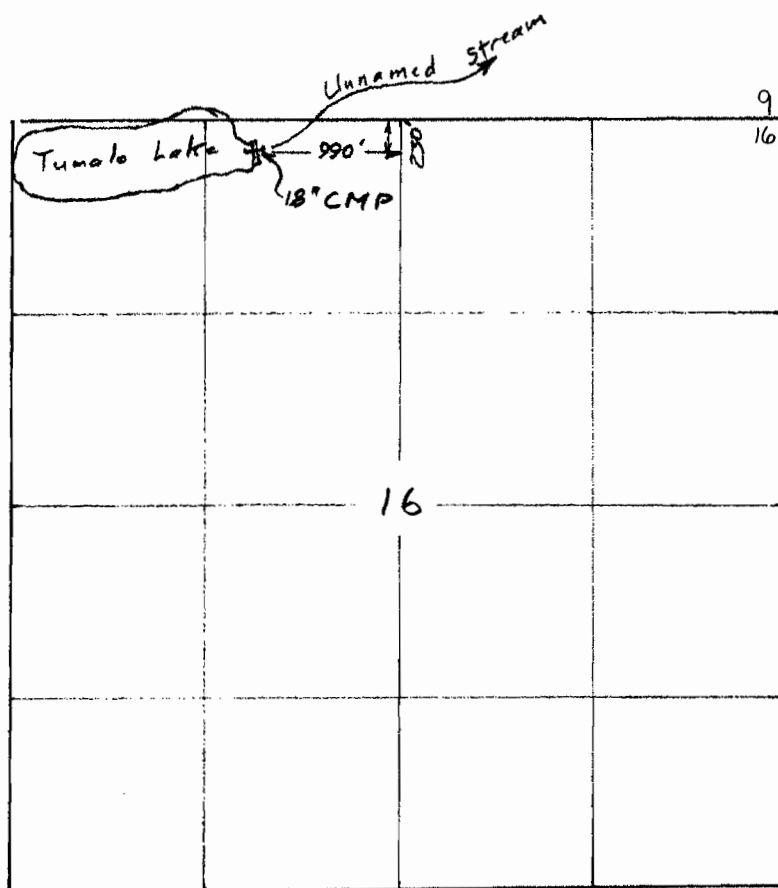

Scale 1"=1320'

Surveyed June 12, 2003


RECEIVED

AUG 09 2004

WATER RESOURCES DEPT
SALEM, OREGON

Claim of Beneficial Use Map
for
JEAN KIRSCH

App R-84763
Per R-13524

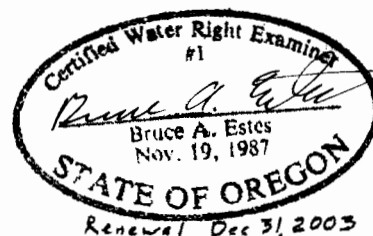

This map is for the purpose of
locating a water right only
and has no intent to provide
legal dimensions or the location
of property lines.

ESTES SURVEYS, LLC

PO Box 17519
Salem, OR 97305-7519
(503) 585-7593

60382 Arnold Rd
Bend, OR 97702
(541) 382-7391