


C-45-9

RECEIVED  
MAY 1993  
WATER RESOURCES DIVISION  
STATE OF OREGON

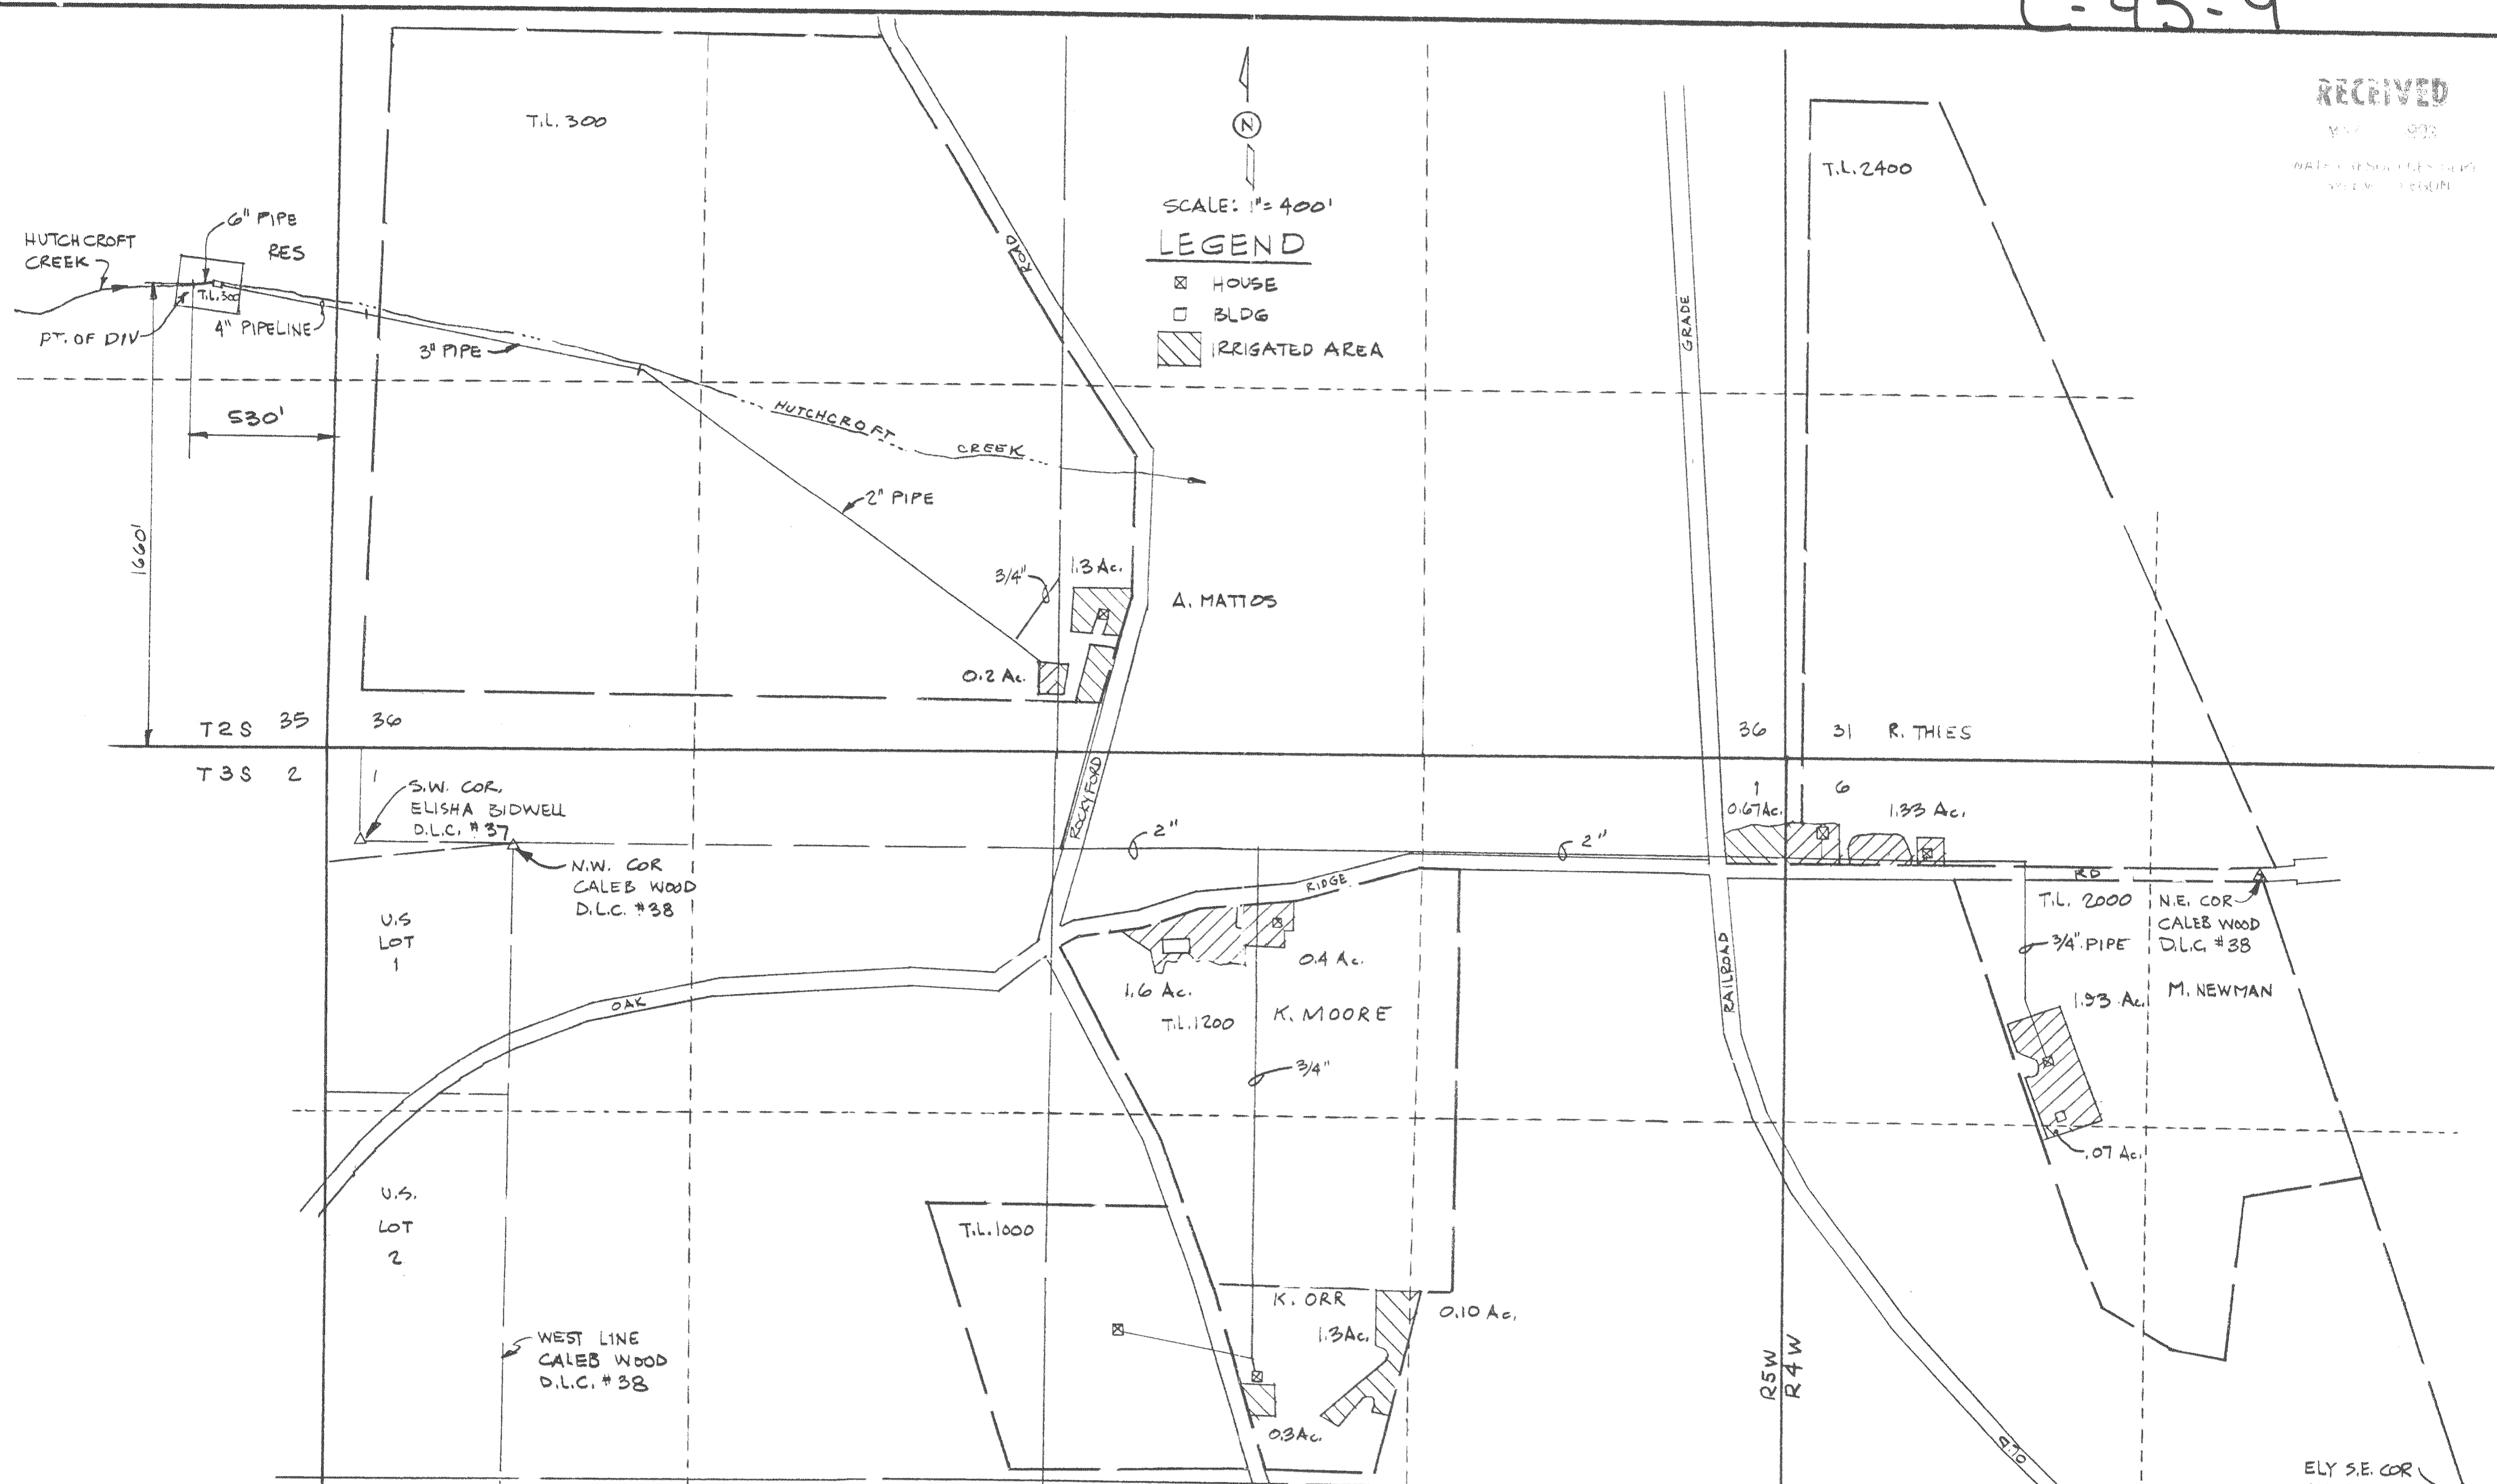

SCALE: 1" = 400'

LEGEND

- ☒ HOUSE
- BLDG
- ▨ IRRIGATED AREA

MARCH 13, 1993  
FINAL PROOF SURVEY

UNDER  
APPLICATION No. 70082 PERMIT No. 50952

**VERBOORT ENGINEERING**  
 AGRICULTURE · CIVIL · WATER RESOURCES  
 HILLSBORO, OREGON

by date  
 designed WRV 3-18-93  
 drawn JER 3-18-93  
 checked WRV 3-18-93  
 drawing no. 93-C-02  
 sheet no. 1/1



HUTCHCROFT WATER COMPANY  
 11900 N.W. OAK RIDGE ROAD  
 YAMHILL, OR 97148

map tube #C-45-9