


TOWNSHIPS 4,5 & 6 SOUTH, RANGE 3 WEST, W.M.

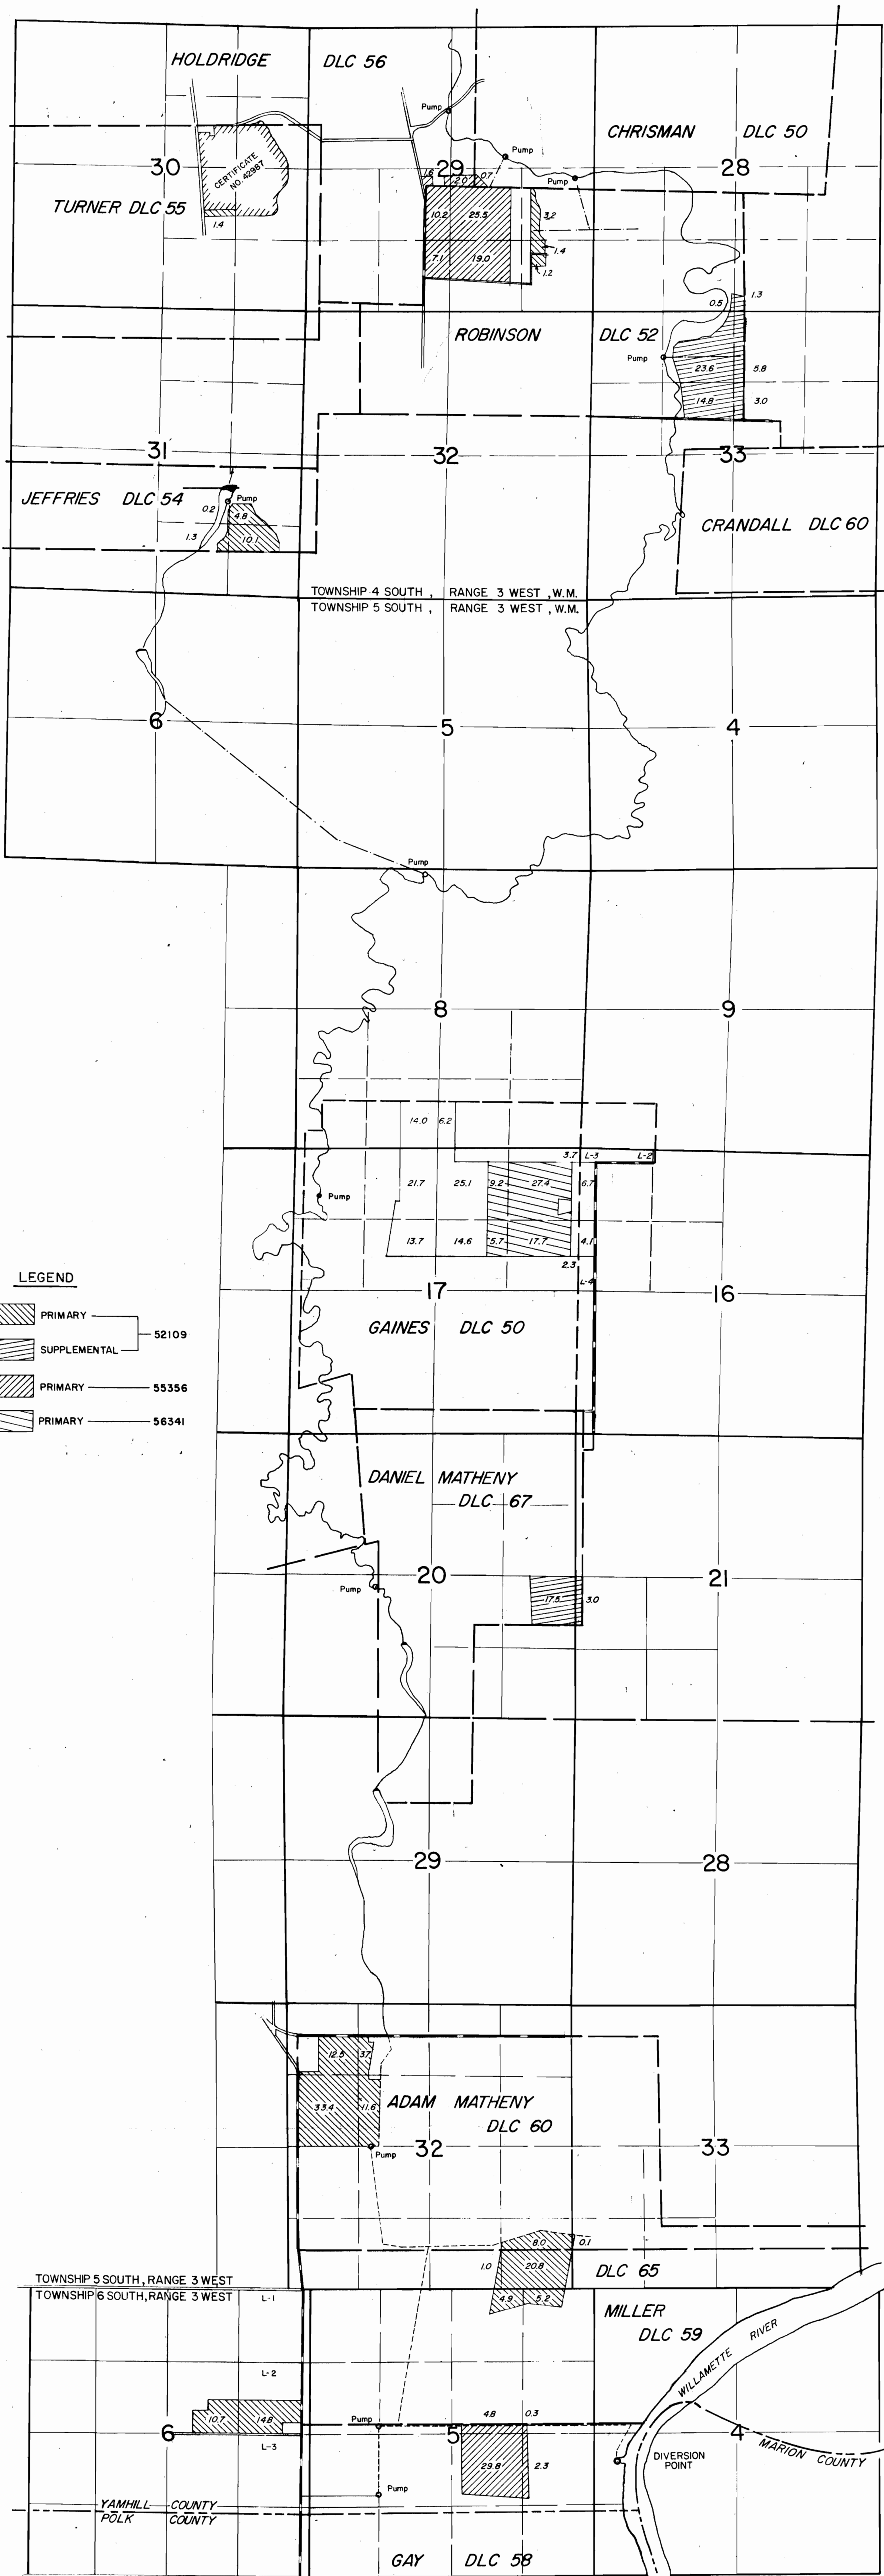

DIV. PT. LOCATED: 4700'N. and 1290'E. from S.E. cor. GAY DLC 58.

FINAL PROOF SURVEY

52109 39385
 55356 41499
 Application No. 56341 Permit No. 42316
 IN NAME OF

PALMER CREEK WATER DISTRICT IMPROVEMENT COMPANY

Sep. 9, 1977 and L. H. Nunn
 Mar. 6, 1978
 Surveyed May 8, 10, 11, 30, 1979 by S. C. Brown