


T.5S., R.6W., W.M.

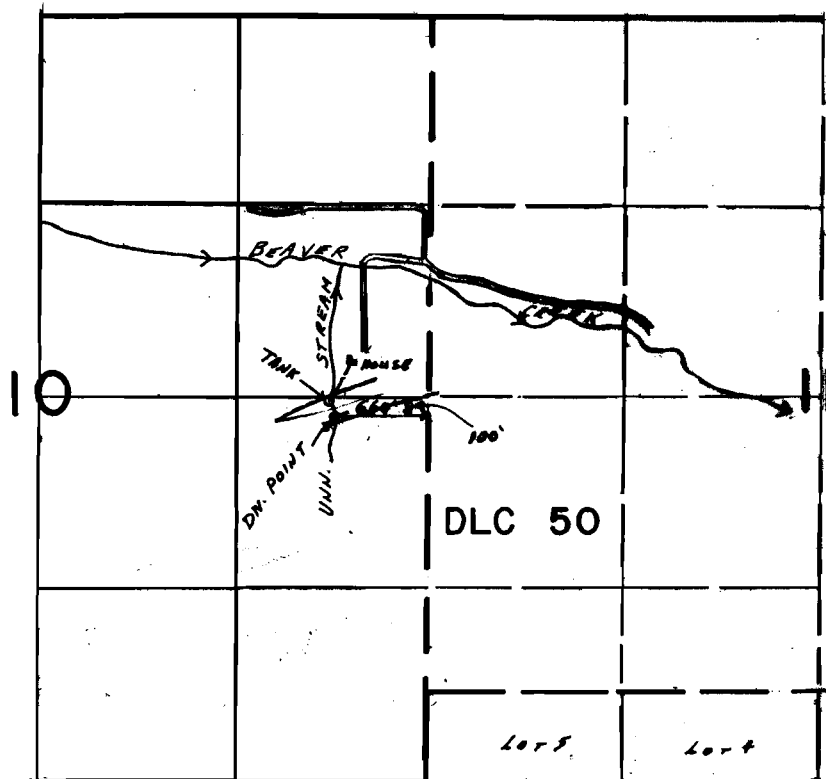

POD : Approximately 75 ft N & 700 ft W from the
E 1/4 corner Section 10.

SCALE 1" = 1320'

FINAL PROOF SURVEY
UNDER

Application No. **66956**.. Permit No. **48133**....
IN NAME OF

DOLPH J. EBERHART

Surveyed **OCT. 12 1988**, by **Z. SALEH**

41071-178-21R
12-16-88 Z.F.S.
REVISED 3/6/89 B-15