


T.16S. R.18E. W.M.

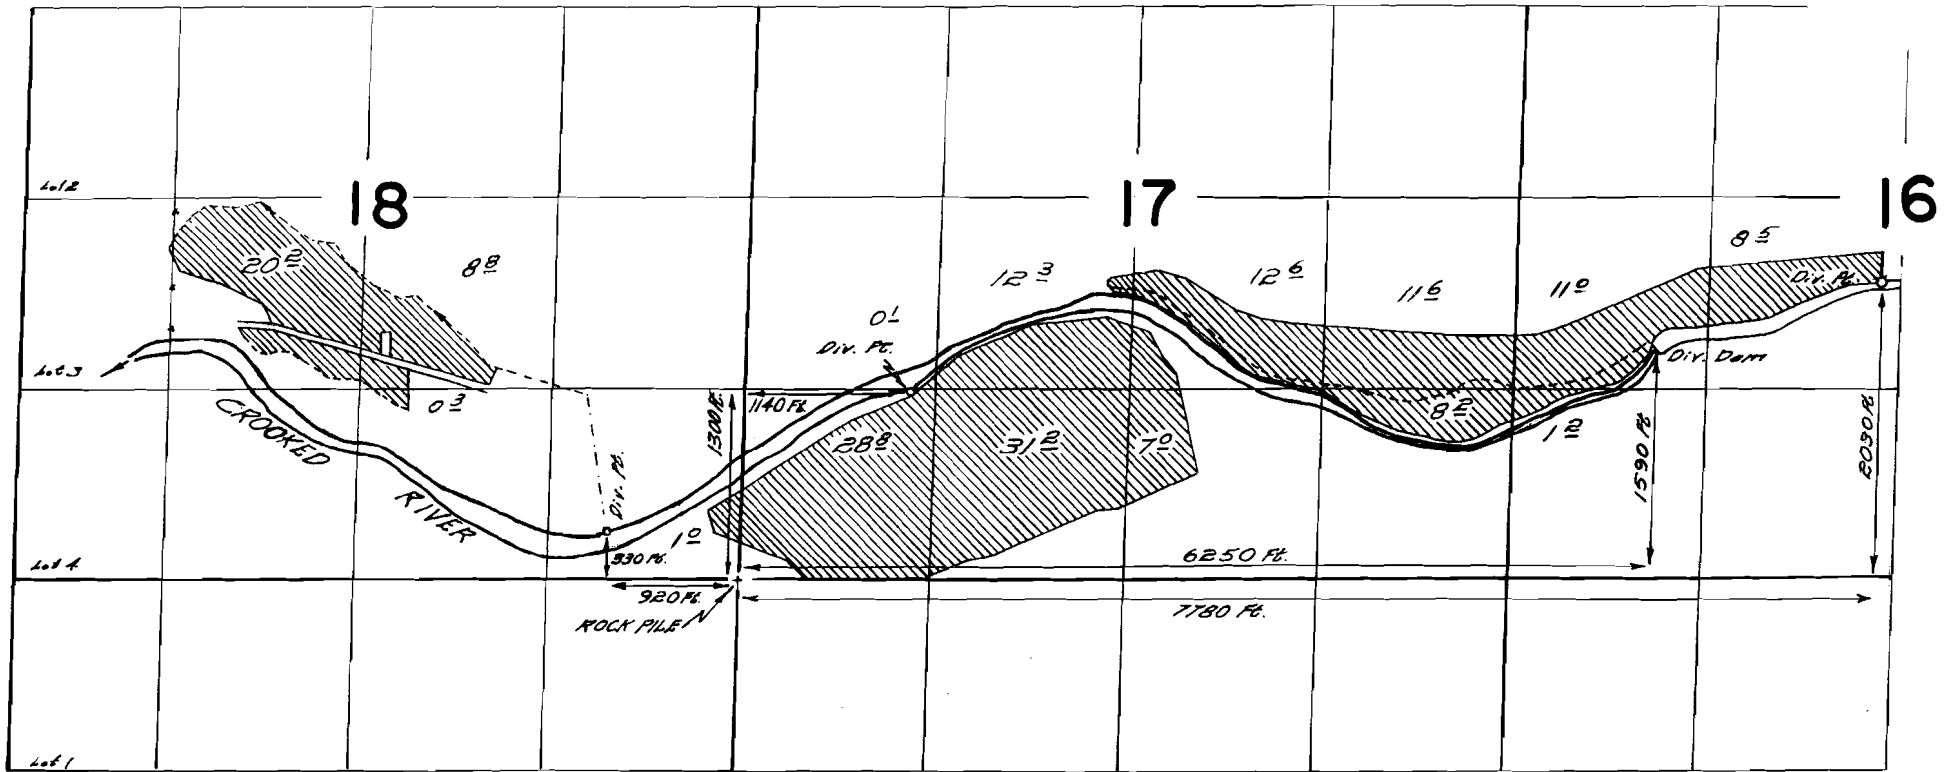

# FINAL PROOF SURVEY

UNDER

APPLICATION No. 33135 PERMIT No. 26204

IN NAME OF

## ROBERT PORFILY


SURVEYED JUNE 10&11, 1968 BY W.J. RUPPERT

**RECEIVED**

AUG 13 2003

WATER RESOURCES DEPT.  
SALEM, OREGON

T. 16S., R. 18E., W.M.

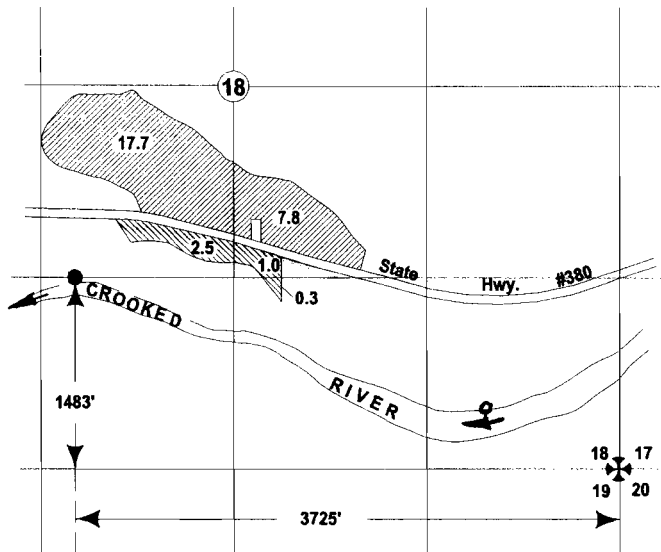

Scale: 1"=1320'

Note: The preparation of this map was for the purpose of identifying the location of the proposed water right and has no intent to provide dimensions or locations of property ownership lines.

**Application Map  
for  
Additional Point of Diversion  
under  
Permit #26204  
(Robert Porfily)**

for  
**Bob Watson**  
by

**- LEGEND -**

● Proposed Div. Pt. (25.5 Ac.)

⊕ Section Corner

 Land to be Irrigated  
by Proposed POD (25.5 Ac.)

 Land under permit #26204  
Not Irrigated by Proposed POD

