


SECTIONS 17, 20, 29, 30, 31 & 32, TWP.2 N. RANGE 21 E. W.M.
 GILLIAM COUNTY, OREGON

RECEIVED

OCT - 3 1994

WATER RESOURCES DEPT.
 SALEM, OREGON

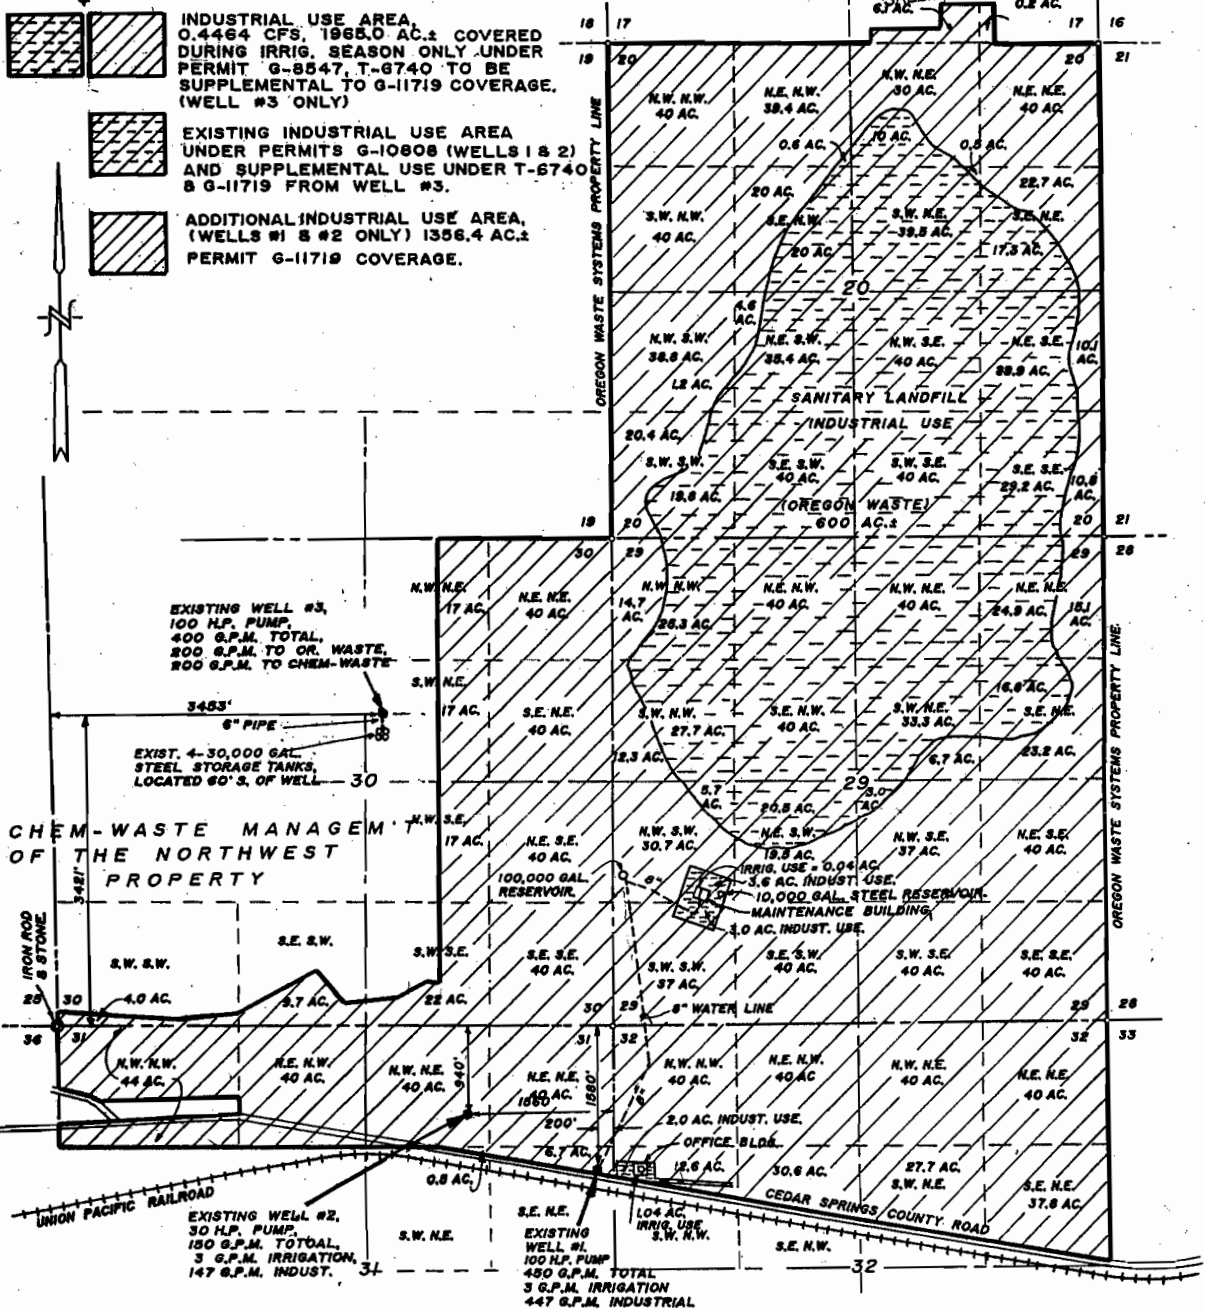

FINAL PROOF SURVEY


SCALE: 1" = 1320'

PERMIT No. T-6740 (G-8547)
G-11719

IN THE NAME OF:
OREGON WASTE SYSTEMS, INC.
 (COLUMBIA RIDGE LANDFILL & RECYCLING CENTER)

DATE: SEPTEMBER 20, 1994

BY: TENNESON ENGINEERING CORP.
 409 LINCOLN STREET,
 THE DALLES, OREGON. 97058
 PH. (503) 298-9177

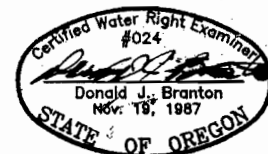

NOTE:

"THIS MAP IDENTIFIES THE LOCATION OF THE WATER RIGHT ONLY AND IS NOT INTENDED TO PROVIDE DIMENSIONS OR LOCATE PROPERTY OWNERSHIP LINES."

W.O. #7750