


T. 4 S. R. 3 W. W.M.

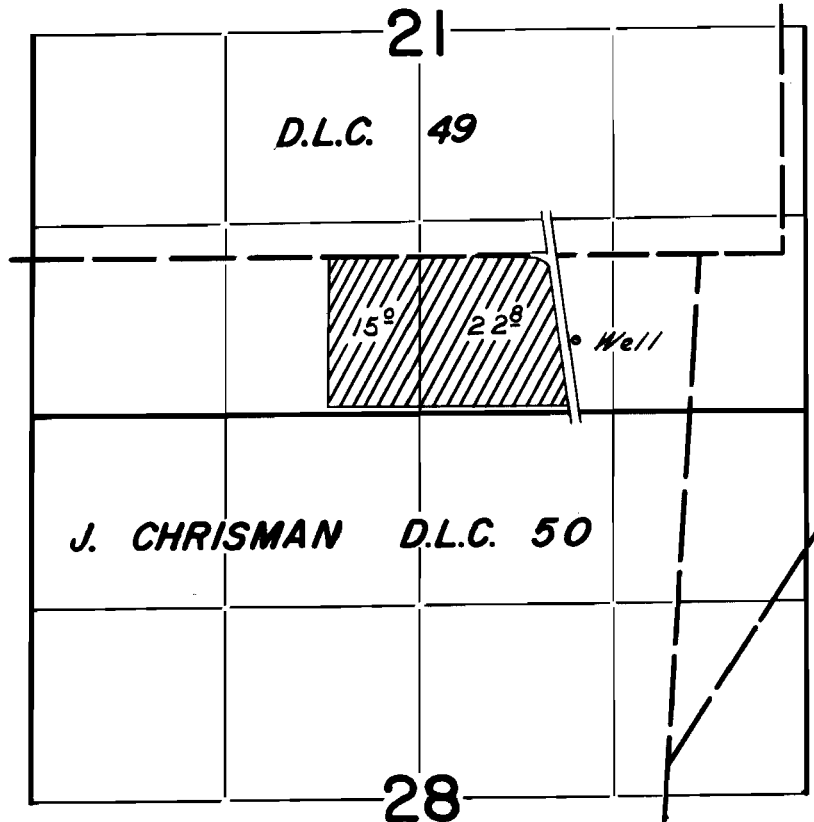

**FINAL PROOF SURVEY**  
UNDER

Application No. G-2172 Permit No. G-2003.  
IN NAME OF

**PAUL A. & EVELYN N. TRENT**

Surveyed Aug. 28 1962, by R. Jackson.....