


# T. 1 S. R. 43 E. W. M.

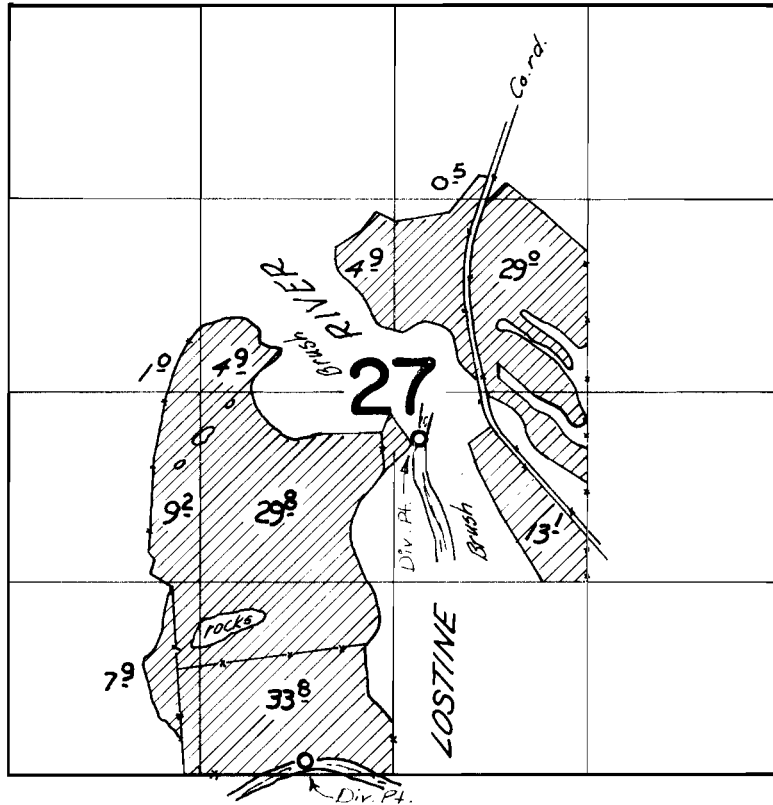

Div. Pts. located 600 ft. W. & 100 ft. N. and 170 ft. E. & 2310 ft. N.  
both from the S  $\frac{1}{4}$  corner of Section 27

## FINAL PROOF SURVEY UNDER

Application No. 34165 Permit No. 26916  
IN NAME OF

*DONEL E. COURTNEY*

Surveyed June 28 1966, by V. GARNER