


T. 1 S. R. 43 E. W. M.

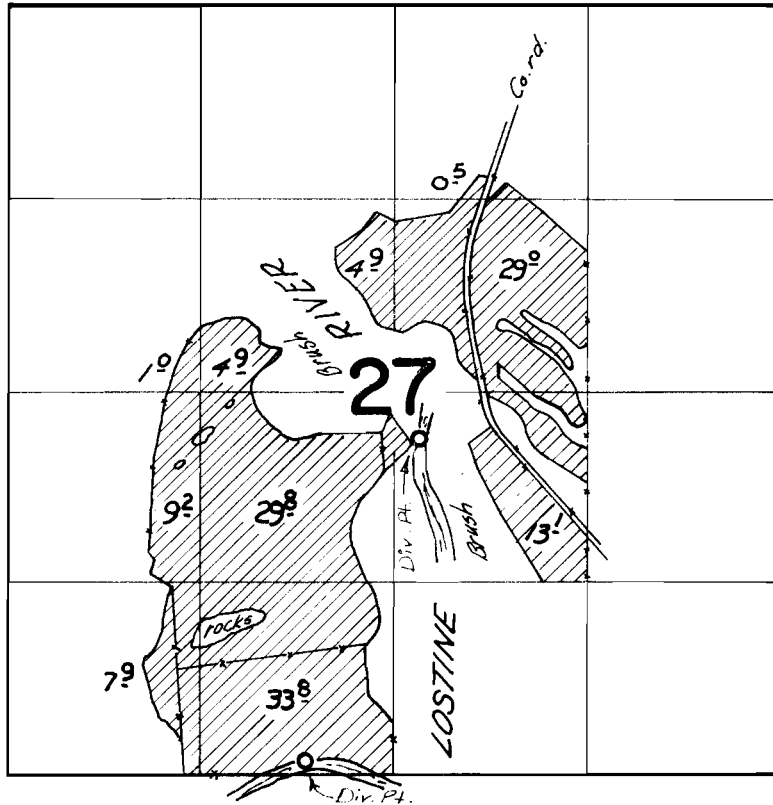

Div. Pts. located 600 ft. W. & 100 ft. N. and 170 ft. E. & 2310 ft. N.
both from the $S\frac{1}{4}$ corner of Section 27

FINAL PROOF SURVEY UNDER

Application No. 34/65 Permit No. 269/6
IN NAME OF

DONEL E. COURTNEY

Surveyed June 28 1966, by V. GARNER