


T. 5 S., R. 2 W., W.M.

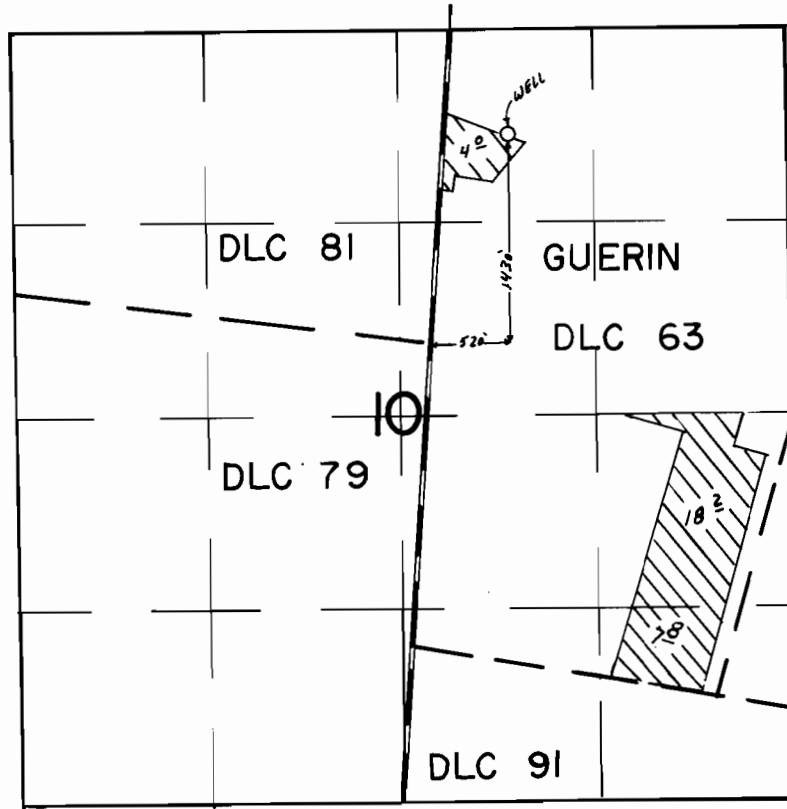

SCALE 1" = 1320'

FINAL PROOF SURVEY
UNDER

Application No. G-11301 Permit No. G-10419
IN NAME OF

ROBERT L. SCHMIDT

Surveyed APRIL 27 1988, by Z. SALEH

DFN-5LL-258
5-23-89 z.f.s.