


T. 16S. R. 16&17E. W. M.

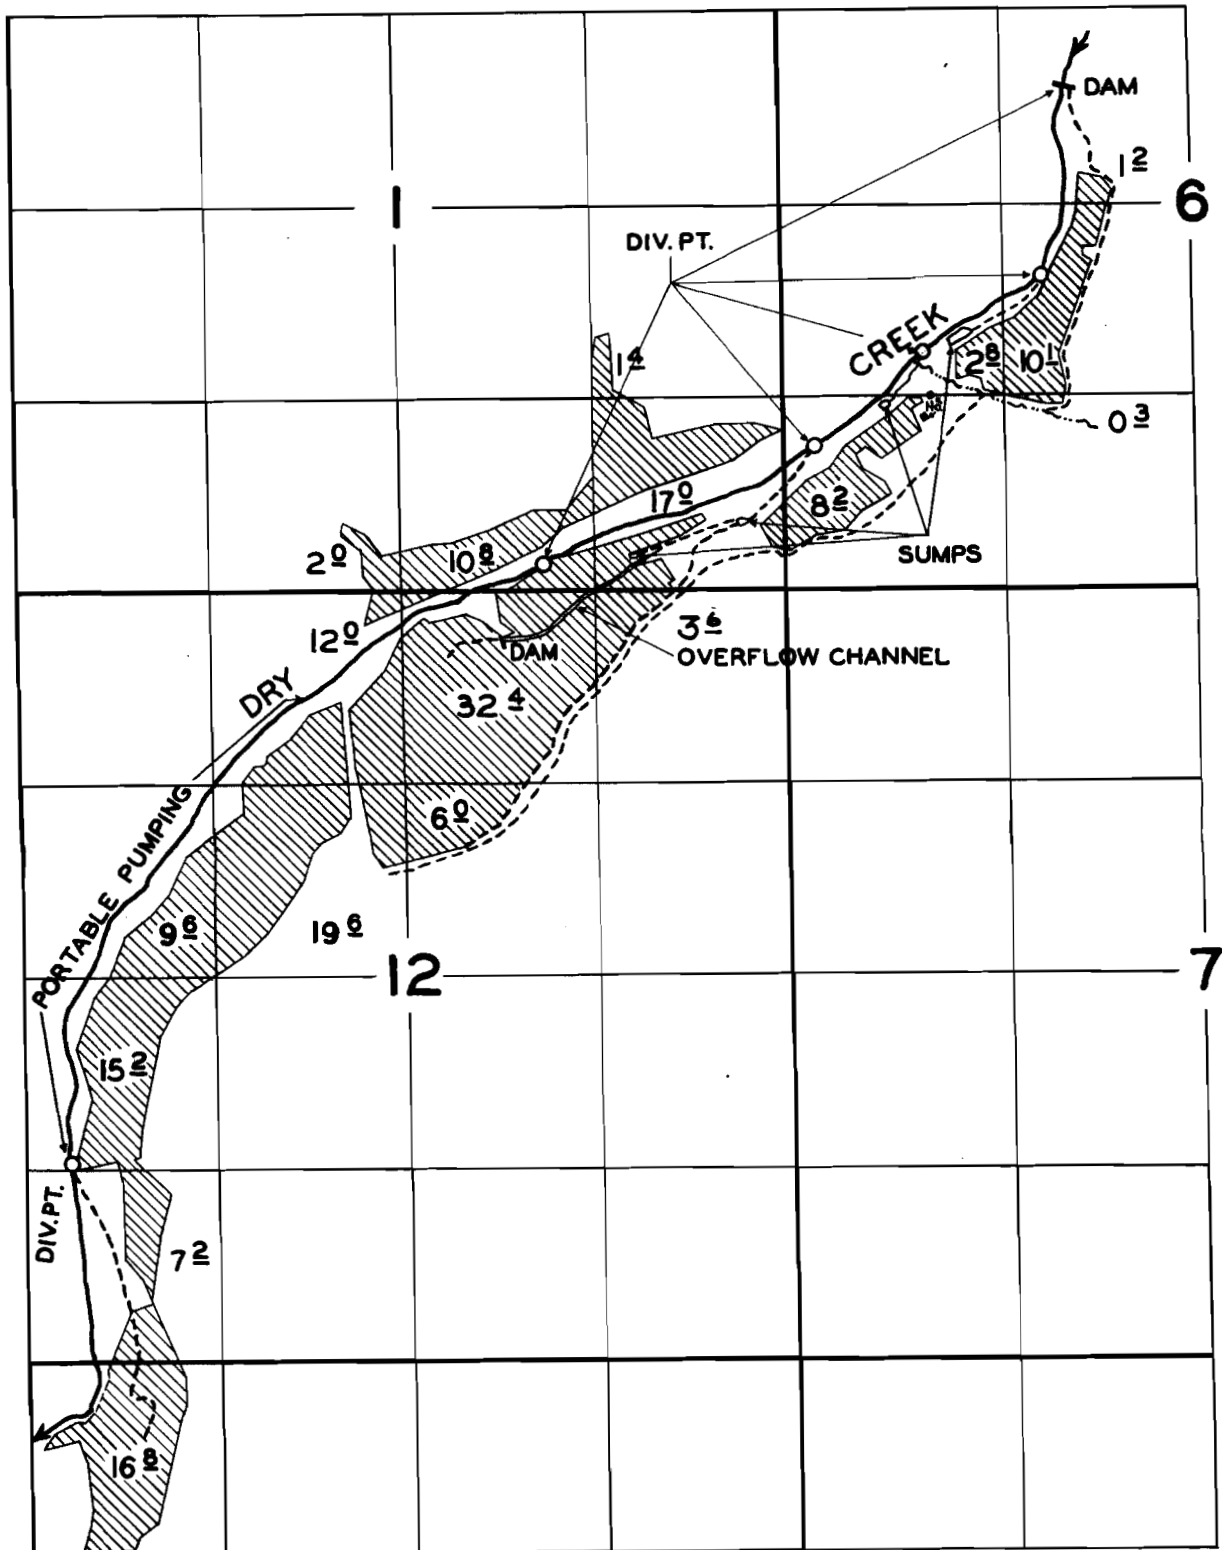

FINAL PROOF SURVEY

UNDER

Application No. 26914 Permit No. 21149

IN NAME OF

ORVILLE YANCEY

RECEIVED

APR 15 1991

WATER RESOURCES DEPT.
SALEM, OREGON

SW 1/4 SW 1/4 Sec. 12


T. 16 S., R. 16 E. w.m.

400' = 1"

RECEIVED

MAY 01 1990

WATER RESOURCES DEPT.
SALEM, OREGON

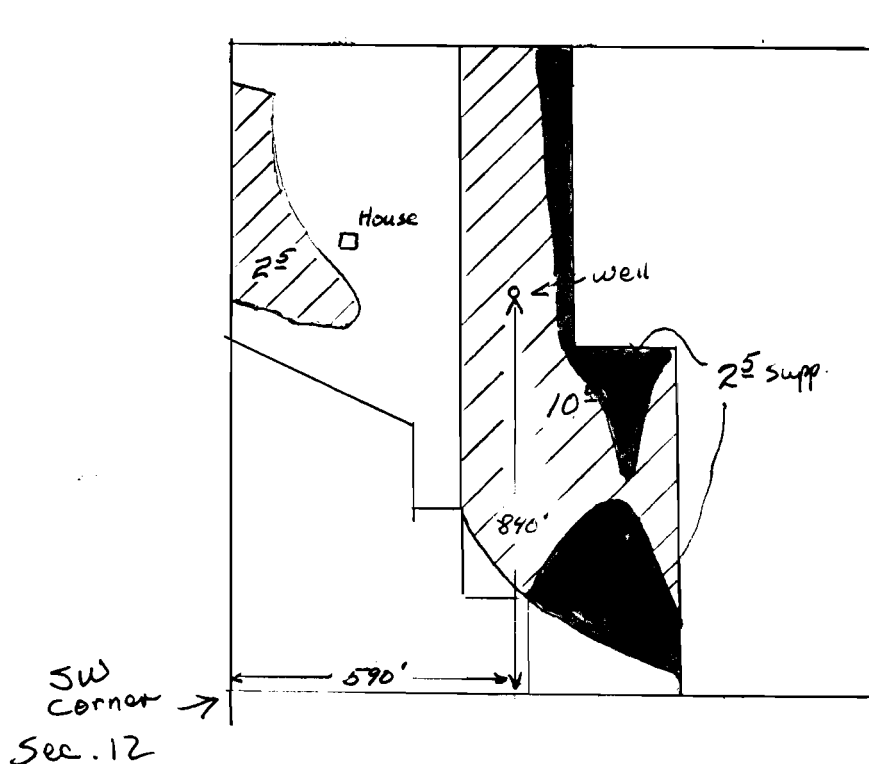

Application No. E-12097
Permit No.

LANDOWNER STATEMENT

WE, FLOYD H. MANNING AND ESTHER L. MANNING, ARE THE CURRENT OWNERS OF THE LAND DESCRIBED IN APPLICATION G-12097.


FLOYD H. MANNING

ESTHER L. MANNING

4-11-91

4-11-91

T. 16^N. R. 16&17E. W. M.

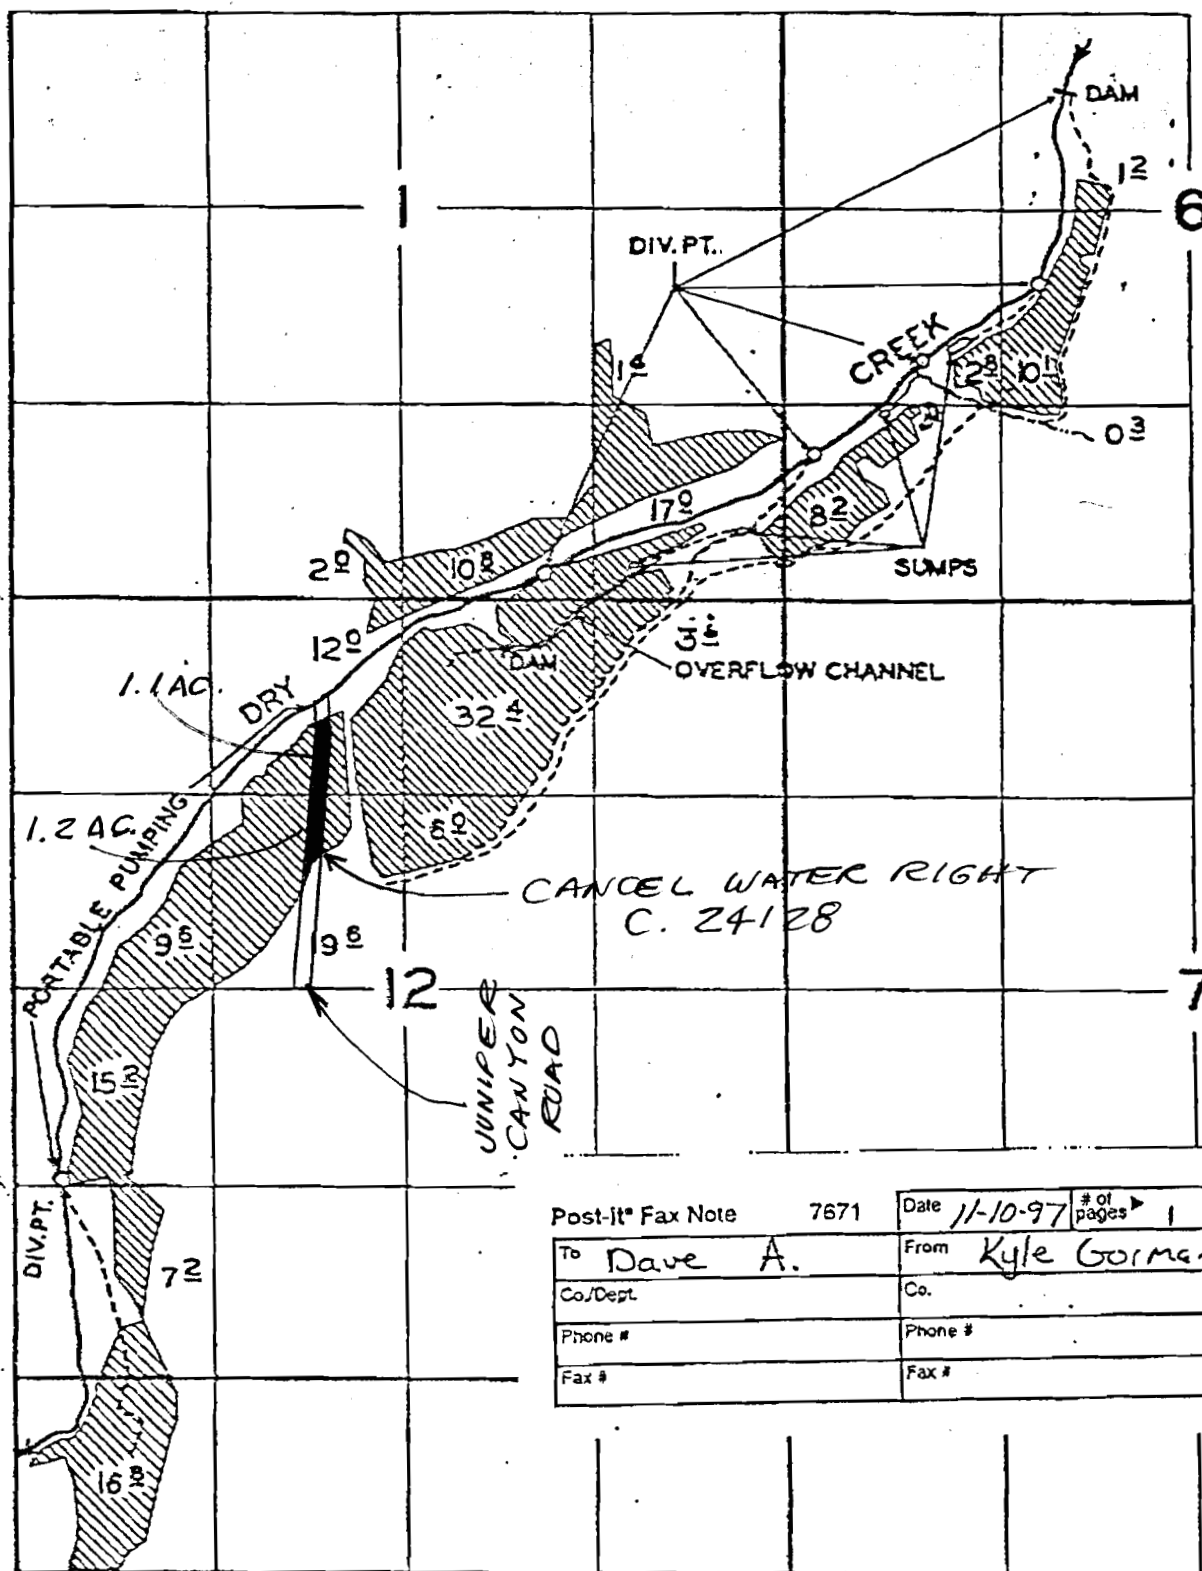

Post-It® Fax Note	7671	Date	11-10-97	# of pages	1
To	Dave A.		From	Kyle Gorman	
Co./Dept.			Co.		
Phone #			Phone #		
Fax #			Fax #		

FINAL PROOF SURVEY

UNDER

Application No. 26914 Permit No. 21149

IN NAME OF

ORVILLE YANCEY


C. 24128

T. 16S. R. 16&17E. W. M.

RECEIVED

JAN 05 1999

WATER RESOURCES DEPT.
SALEM, OREGON

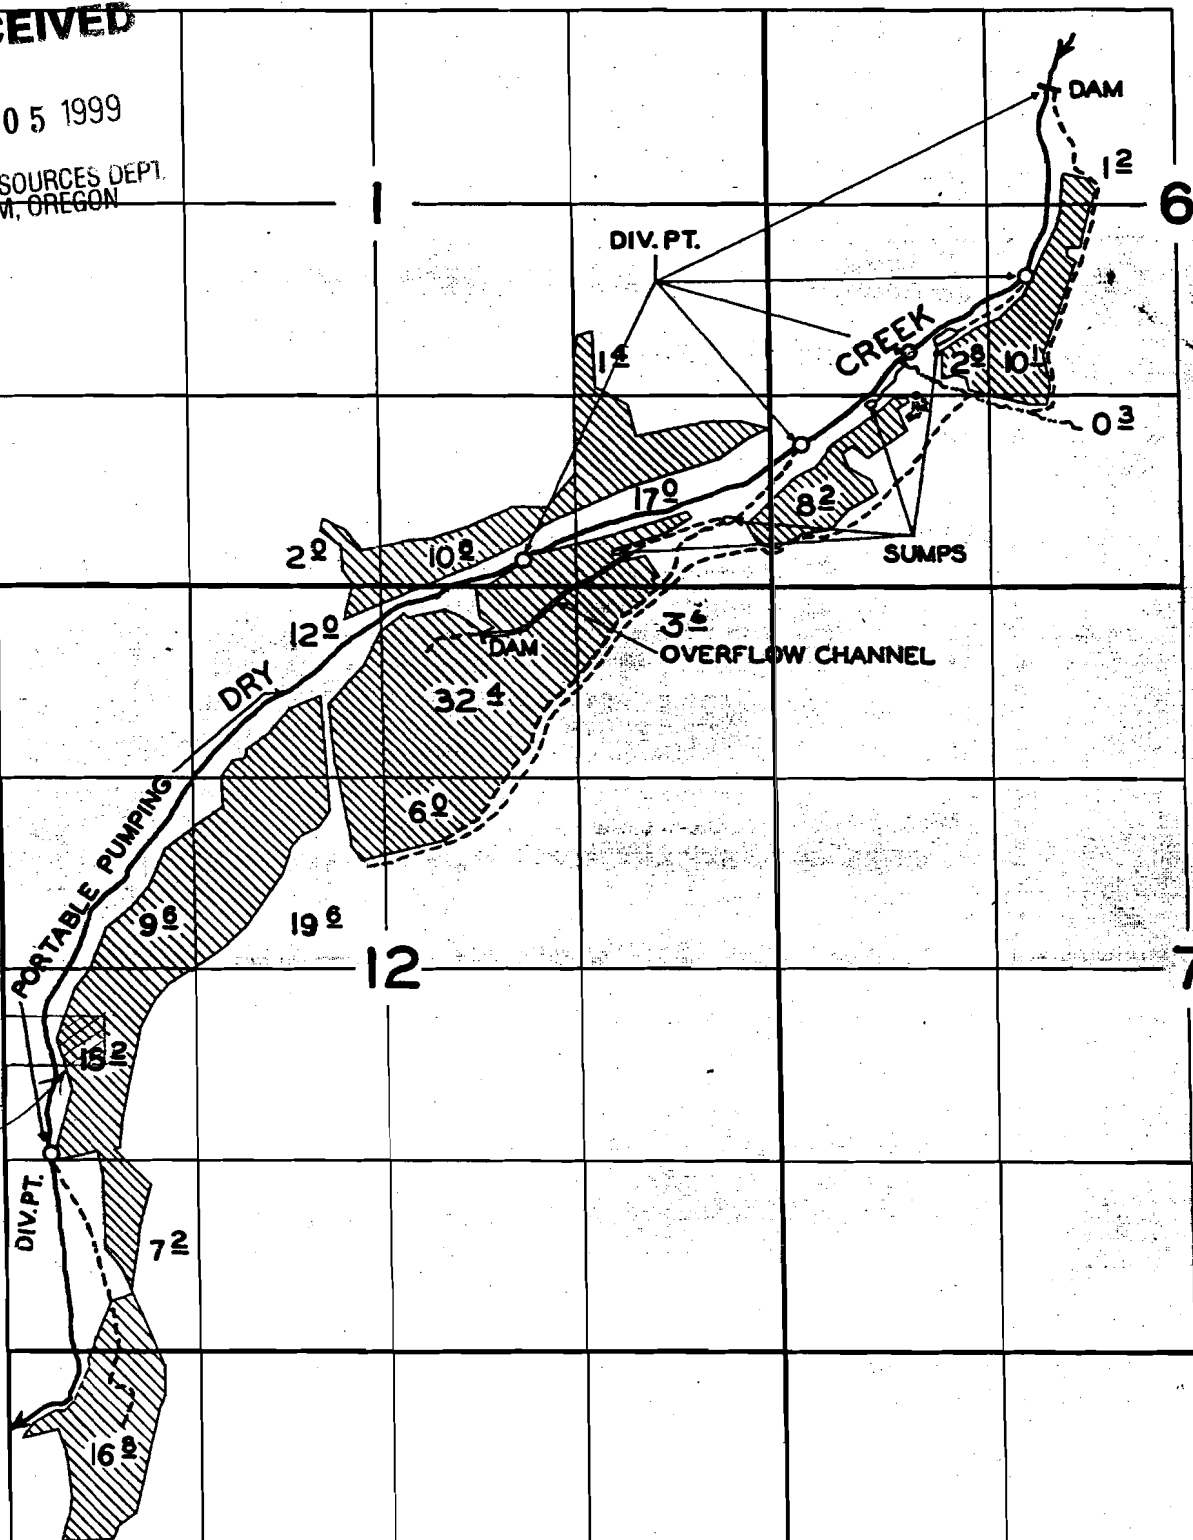

FINAL PROOF SURVEY

UNDER

Application No. 26914 Permit No. 21149

IN NAME OF

ORVILLE YANCEY

Surveyed OCT. 22, 1957, by C. O. Bartels