


T1N, R4W, WM

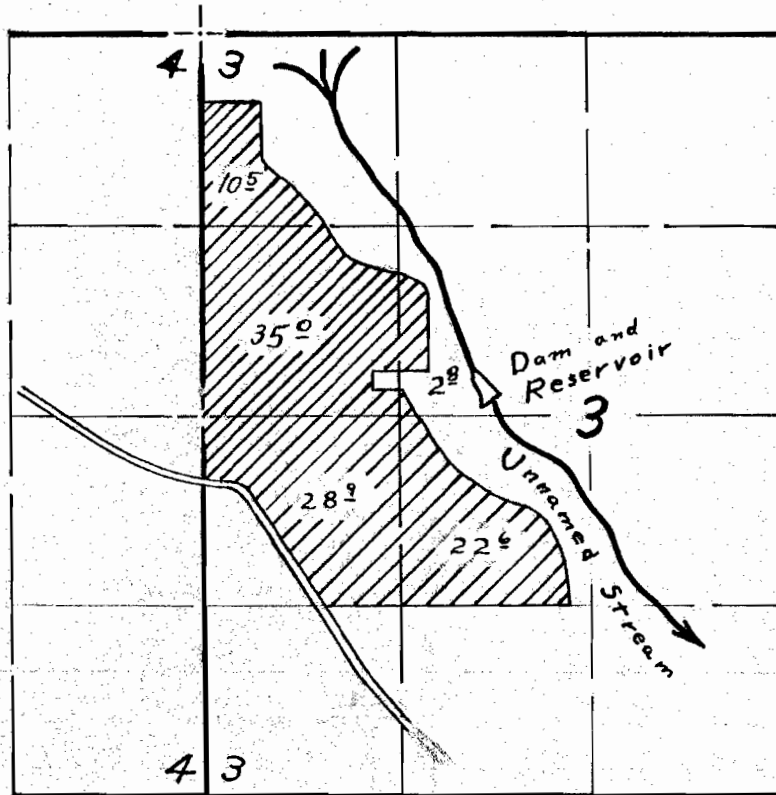

FINAL PROOF SURVEY

UNDER

R-26220 & 26221

R-1232 & 20602

Application No. 24989 Permit No. 19613

IN NAME OF

Richard Spangler

Surveyed 4-18 1956, by RDBest