

To: Steve Braun
From: [unclear]
0901


29779

MAP TO ACCOMPANY TRANSFER APPLICATION
CHANGE IN, AND ADDITIONAL POINTS OF DIVERSION
MODIFYING
PERMIT 29779, CERTIFICATE 39091

T.6N.R.34E.W.M.

T-8722

SECTIONS 21 AND 22
UMATILLA COUNTY, OREGON
APPLICANT: CALVIN N. BLESSINGER

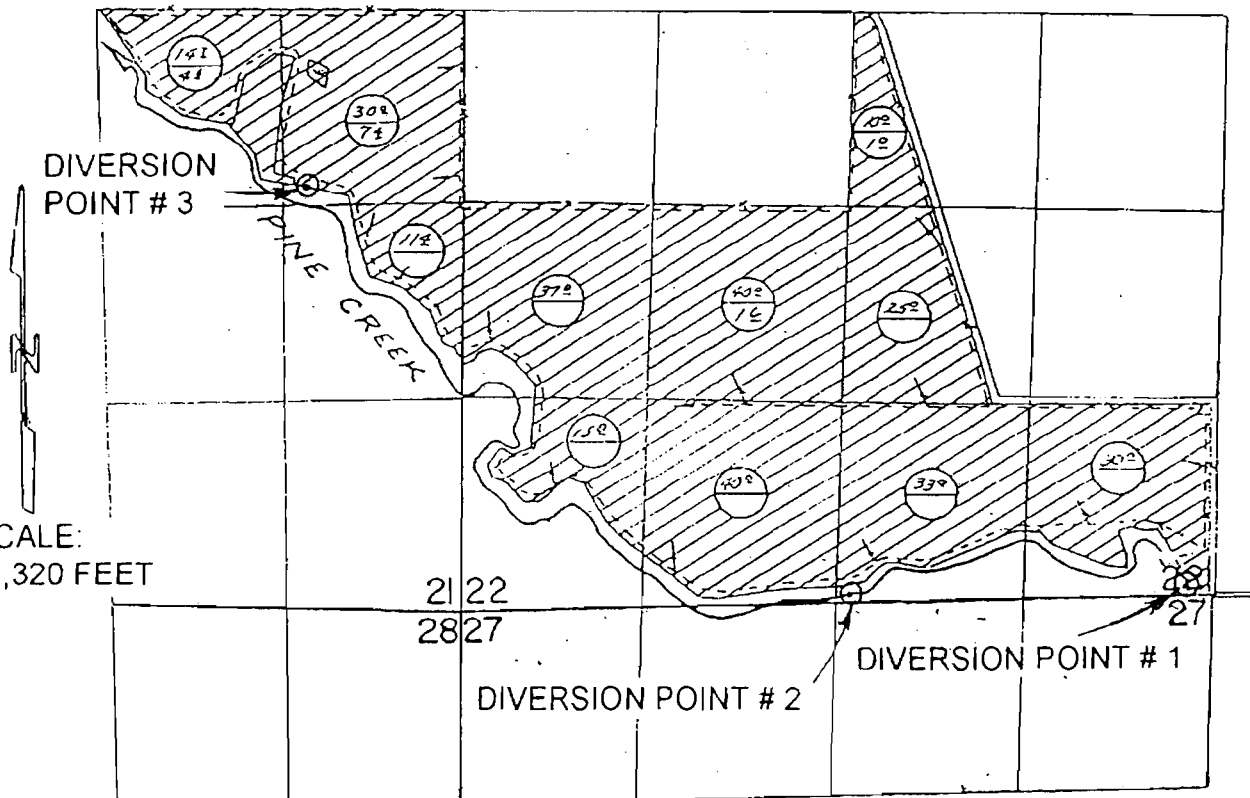

SCALE:
1" = 1,320 FEET

○ — SUPPLEMENTAL
— PRIMARY

LEGEND

○ NEW / ADDITIONAL POINT OF DIVERSION

LOCATION OF PROPOSED POINTS OF DIVERSION

- # 1 40 FEET NORTH AND 275 FEET WEST OF THE SOUTHEAST CORNER OF SECTION 22.
- # 2 2,590 FEET WEST OF THE SOUTHEAST CORNER OF SECTION 22 (ON THE SECTION LINE).
- # 3 2,750 FEET NORTH AND 1,100 FEET WEST OF THE SOUTHEAST CORNER OF SECTION 21.

RECEIVED

MAR 15 2001

WATER RESOURCES DE
SALEM, OREGON

THIS MAP IS PREPARED FOR THE EXPRESS PURPOSE TO SHOW WATER APPROPRIATION AND USE. IT IS NOT INTENDED TO SHOW OR LOCATE PROPERTY

Dennis L. Gaylord
 Certified Water Right Examiner
 # 83
 Dennis L. Gaylord
 Nov. 19, 1987
 STATE OF OREGON

DENNIS L. GAYLORD, C
71614 S.W. LAKE DRIVE
PENDLETON, OR 97801
541 - 276 - 6260