
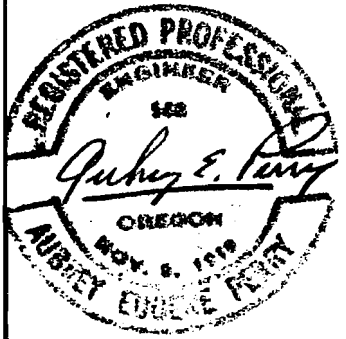


PLAT SHOWING AREA SERVED DOMESTIC WATER
ROATS WELLS #1 and #2
Scale 4" = 1 MILE.

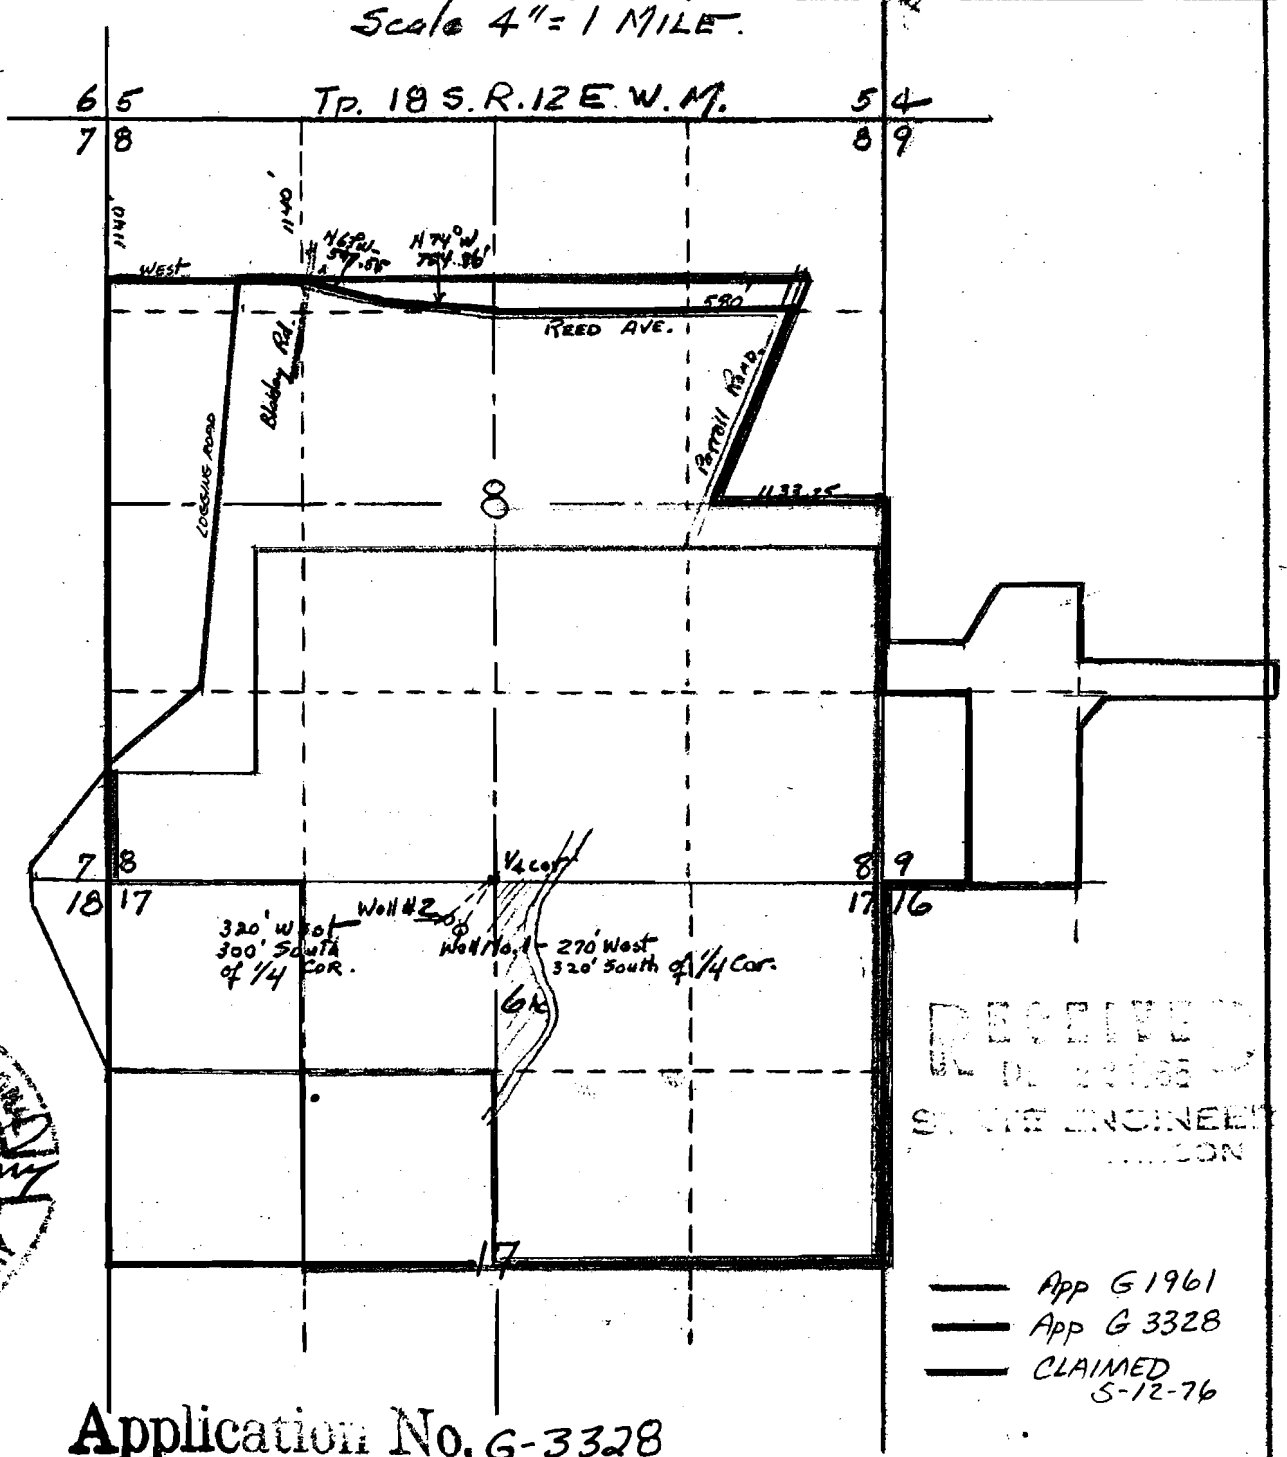

RECEIVED
 DECEMBER 22 1968
 STATE ENGINEER
 OREGON

— App G 1961
 — App G 3328
 — CLAIMED
 5-12-76

Application No. G-3328
 Permit No. G-3128