
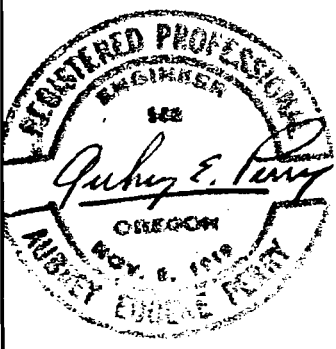
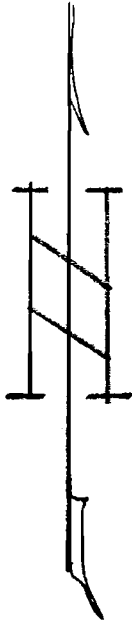


CERTIFICATE NO. 81657 AND 81658

PLAT SHOWING AREA SERVED DOMESTIC WATER
ROATS WELLS #1 and #2

Scale 4" = 1 MILE.

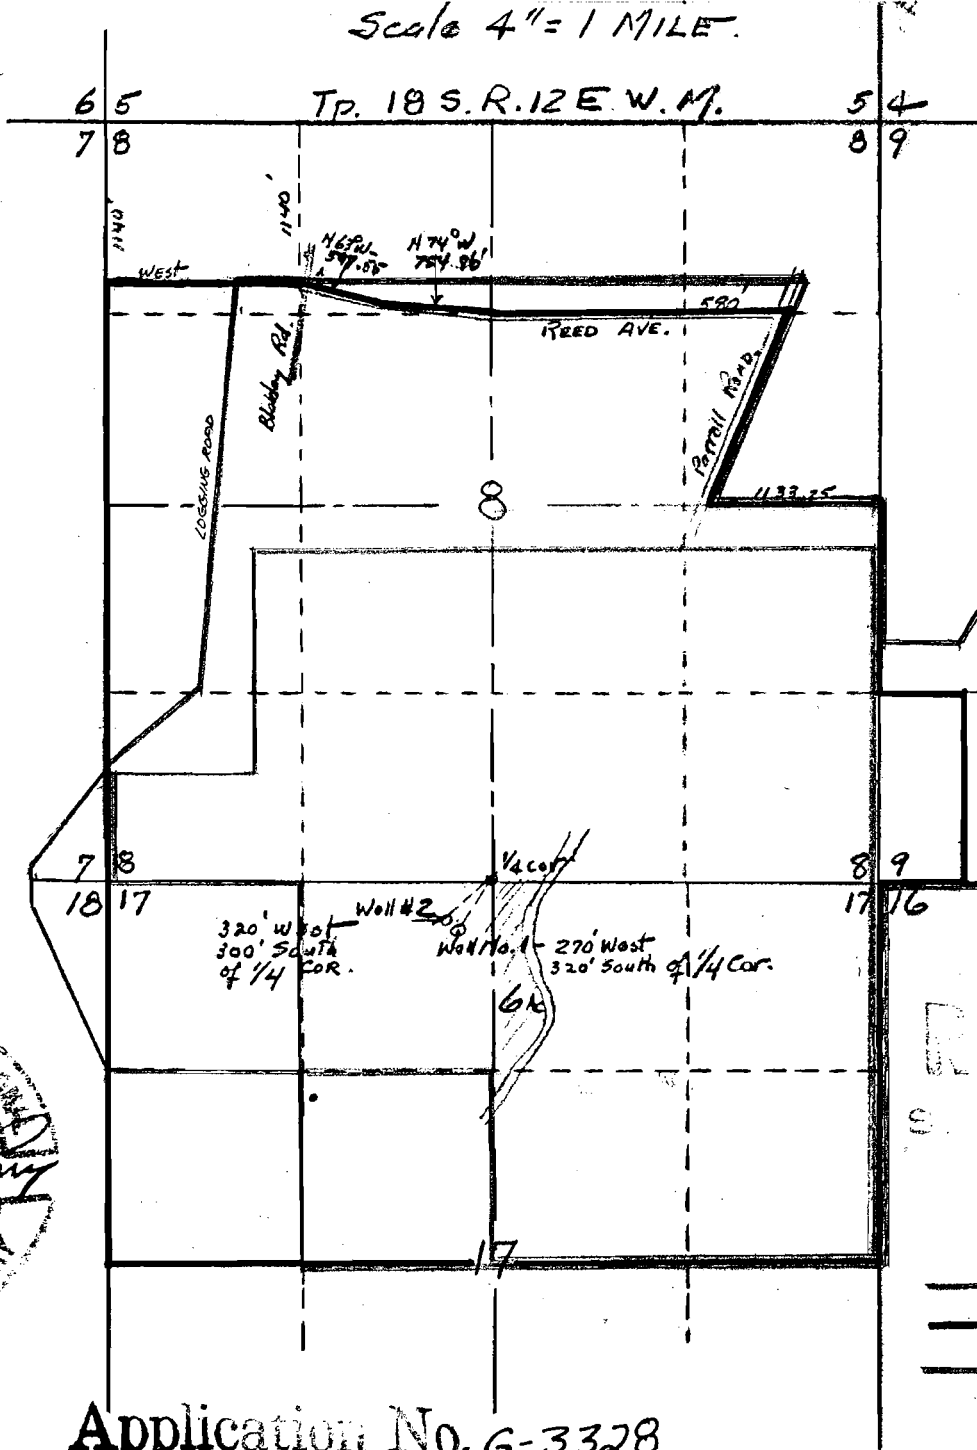

RECEIVED
R. D. BRIDGE
STATE ENGINEER
... CON

— App G 1961
— App G 3328
— CLAIMED
5-12-76

Application No. G-3328
Permit No. G-3128