


T. 9 & 10 S. R. 4 W. W.M.

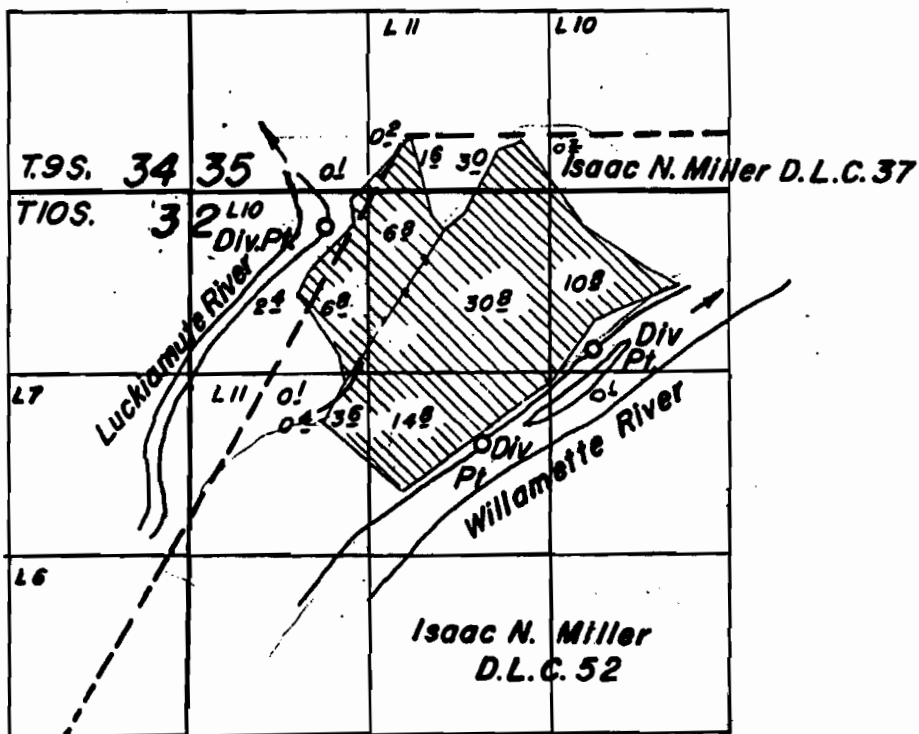

FINAL PROOF SURVEY
UNDER

Application No. 32556 Permit No. 25777
IN NAME OF

Claude W. & Garnet F. Pilcher

Surveyed March 7, 1963, by *Floyd L. Sigmund*