


T.2N., R.3W., W.M.

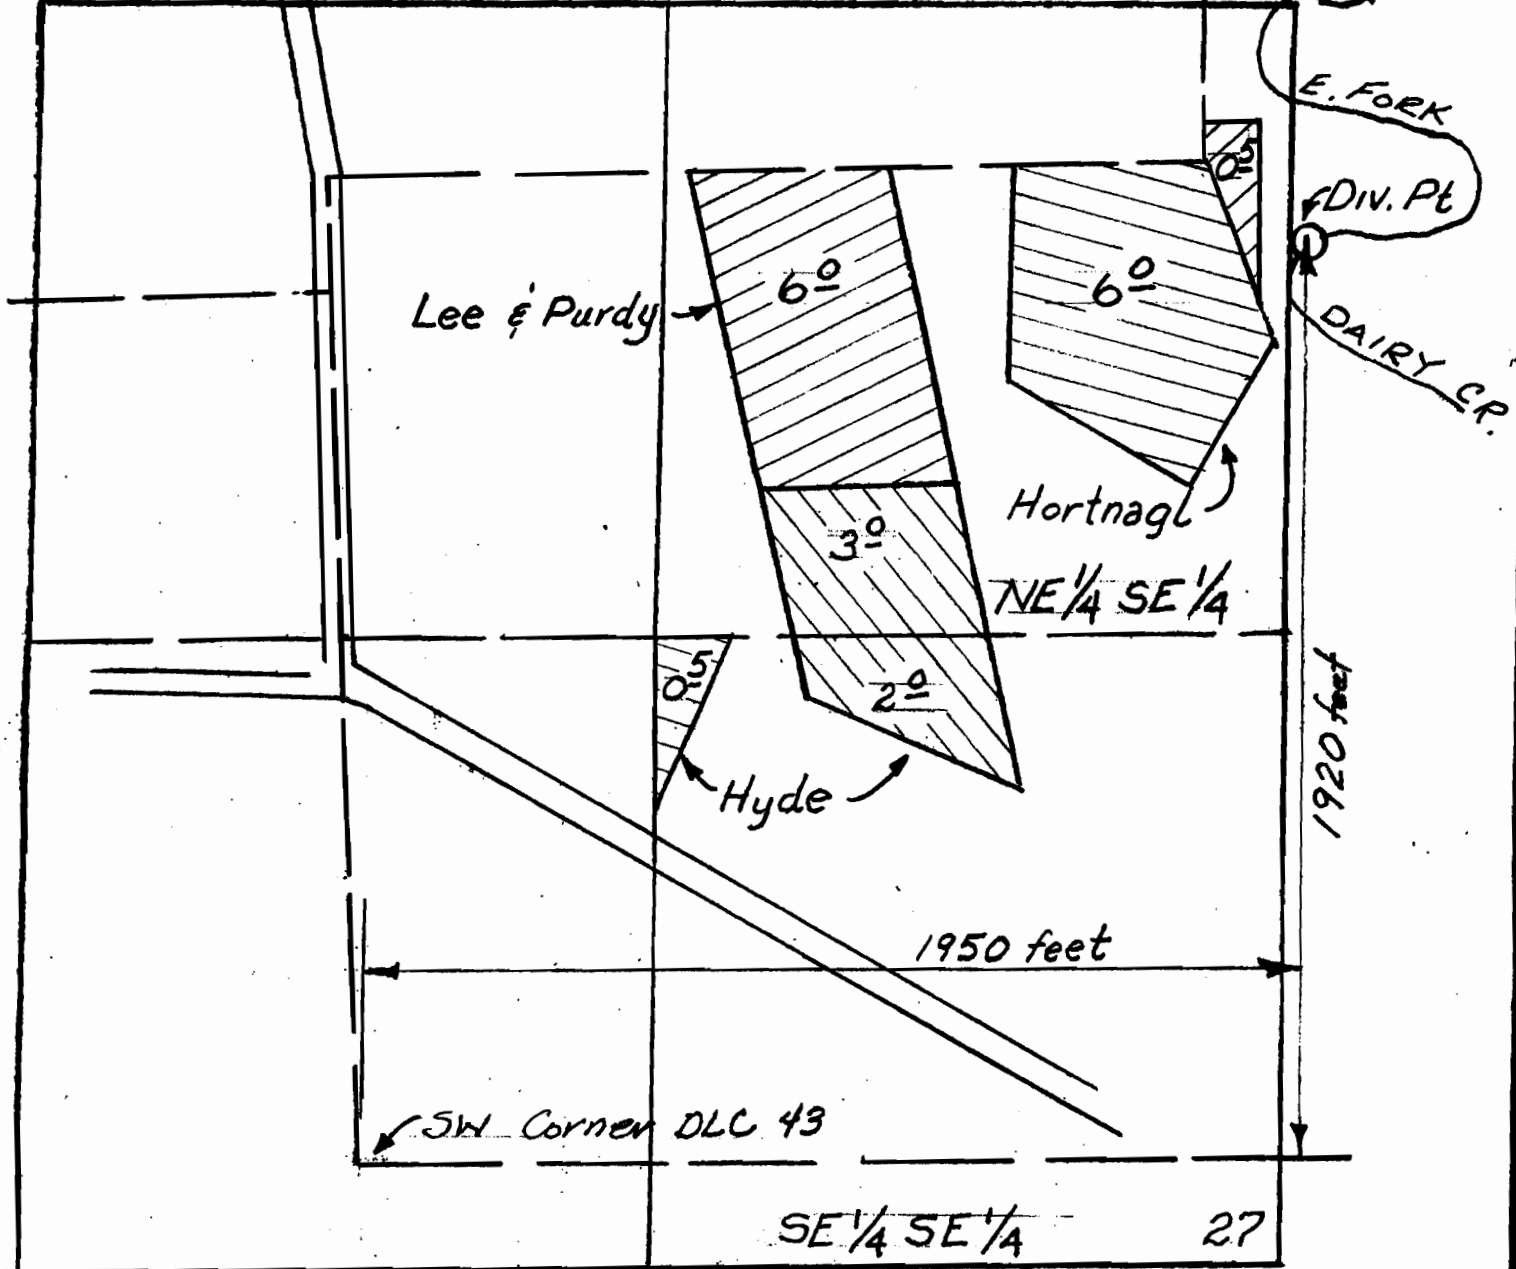

Scale 1" = 400'

**FINAL PROOF SURVEY**  
UNDER

Transfer No. T-2636

Application No. .... Permit No. ....

IN NAME OF

Hyde, Lee-Purdy, Hortnagl

Surveyed 9-22-04, by D. Hedin