


T. 8 S., R. 28 E., W.M.

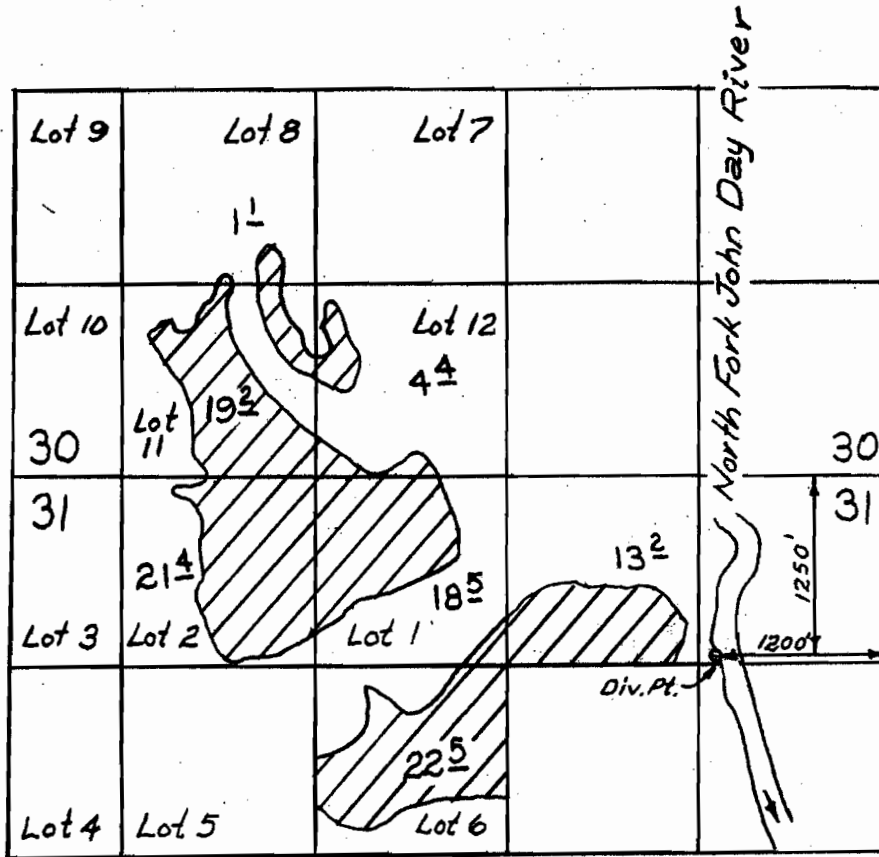

FINAL PROOF SURVEY

UNDER

Application No. 51553 Permit No. 38895
IN NAME OF

CLARA C. FLOWER

Surveyed August 28, 1992, by L. Miller

Redrafted 5-11-05 dkb
DDU-1FF-92, 2-12-96 JM