



Claim of Beneficial Use

Application No. G-12151 Permit No. G-11105

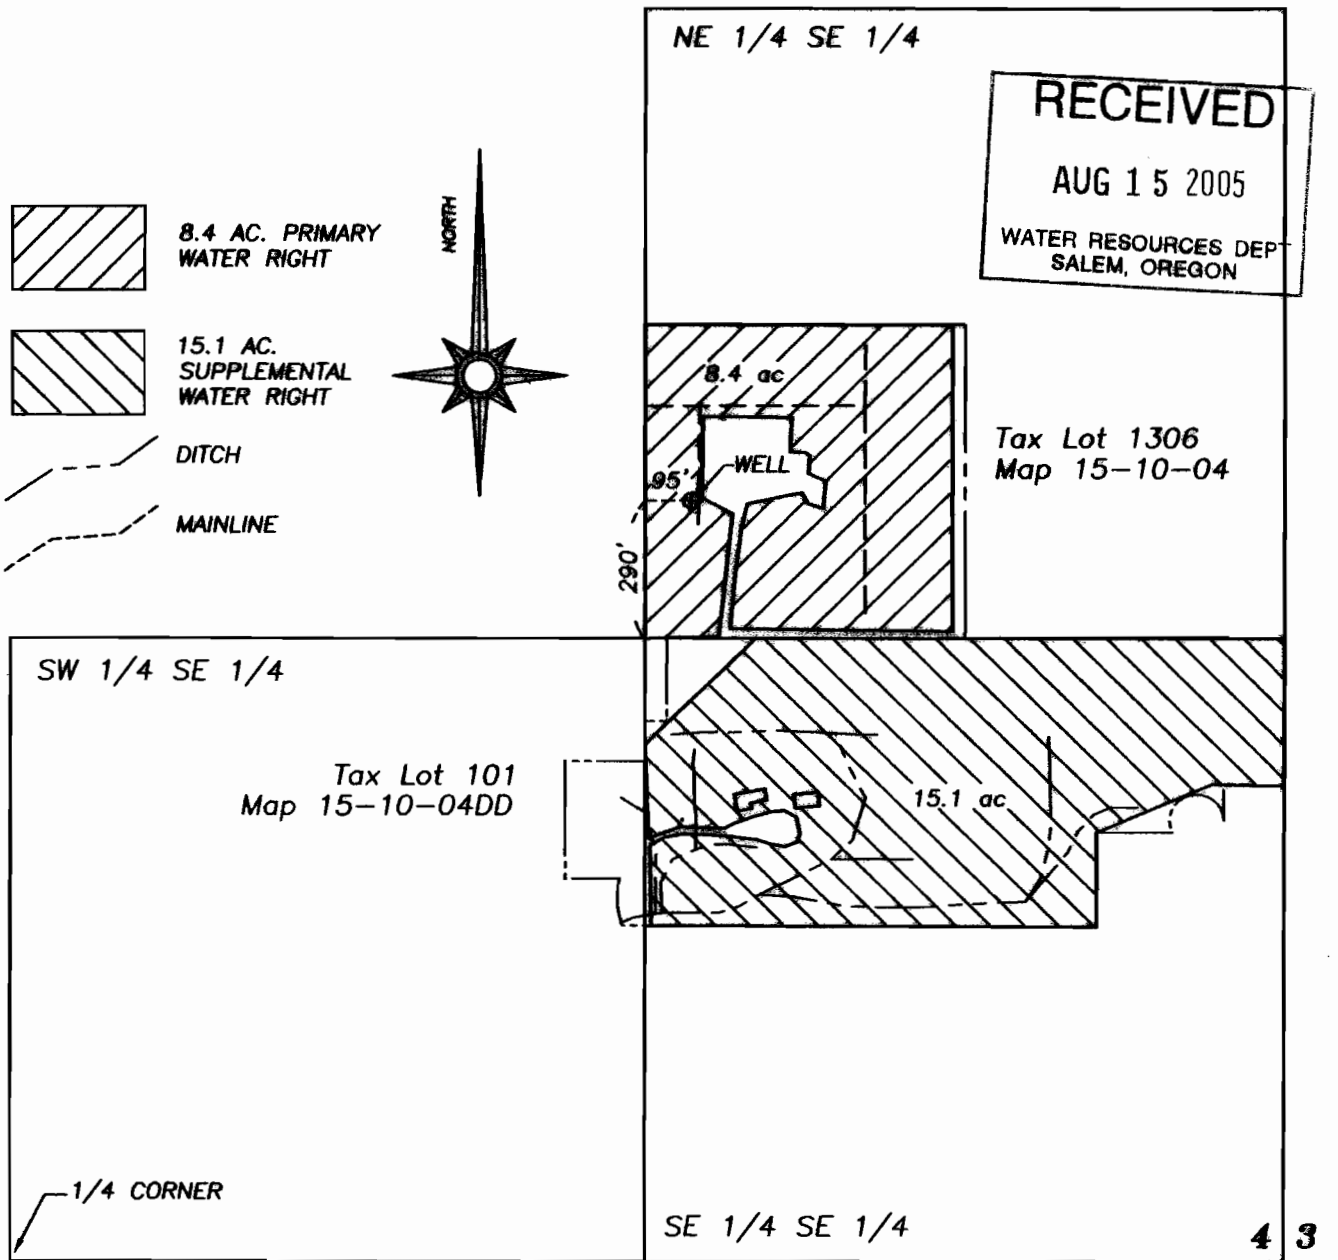

T15S, R10E, W.M. 9 10
Deschutes Co. Oregon

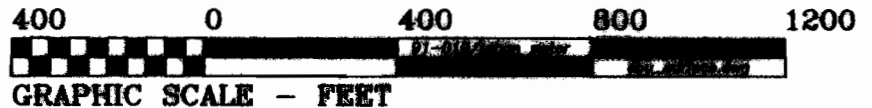

THIS MAP IS FOR THE PURPOSE OF IDENTIFYING THE LOCATION OF THE WATER RIGHT. IT IS NOT INTENDED TO PROVIDE LEGAL DIMENSIONS OR LOCATIONS OF PROPERTY OWNERSHIP LINES.